

ALLEGAN COUNTY REMONUMENTATION
LAND CORNER RECORDATION CERTIFICATE
Filing Requirement of Act 74, Mich. P.A. 1970

For corners in ALLEGAN (County) Located In: Corner Code #
 1. Public Land Survey T 1N R 13W E-1
 T R TRONBRIDGE
 T R
 T R
 T R
 2. Property Controlling in Section S T R
 S T R
 S T R
 S T R
 3. Miscellaneous Property in Sec. S T R
 S T R
 S T R
 4. Lot No. _____, Recorded Plat _____
 5. Private Claims _____

1995 DEC 14 PM 2:39
 REGISTER OF DEEDS
 ALLEGAN COUNTY, MICHIGAN
 FILED

Register of Deeds Stamp & File Number

SURVEY & REMONUMENTATION

APR 29 1996

COMMISSION

	A	B	C	D	E	F	G	H	I	J	K	L	M
2	6	5	4	3	2	1							
3													
4	7	8	9	10	11	12							
5													
6	13	14	15	16	17	18							
7													
8	19	20	21	22	23	24							
9													
10	25	26	27	28	29	30							
11													
12	31	32	33	34	35	36							
13													

I, DONALD R. PITTS, JR. in a field survey on JULY 27, 1995, do hereby certify that under requirements of P.A. 74, Michigan P.A. of 1970, the corner points mentioned in lines 1 and 2 above were in conformance with regulations and rules therefore as required in the current manual of survey instructions of the United States Department of the Interior, Bureau of Land Management or by a decree of a Court of Law and/or that the corner points mentioned in lines 3, 4 and 5 above were in conformance with the rules of the Michigan Board of Land Surveyors or by a Decree of a Court of Law, established, re-established, monumented, re-monumented, recovered, found as expressed below:

NOTE: Not more than 4 corners, all in the same town and range, may be recorded on this certificate.

A. Description of original monument and accessories and/or subsequent restoration:

G.L.O. INTERSECTED N. BOUNDARY LINE 265 LKS W OF POST & SET POST CORNER SECTIONS 4 & 5 BUTTERNUT 5 S 28 W 50 W ASH 6 S 19 E 48
 1974 SMITH AND SMITH LIBER 855, PAGE 300 ESTABLISHED E 1/4 POST SEC 5 ON LINE FROM SE COR TO LOCUST TREE WITH OLD FENCE ON TOP OF BLUFF AND DOUBLING DISTANCE FROM SE COR TO 1/8 LINE FENCE TO NORTH IN SEC 5. LOCUST TREE 1291.85 NORTH OF ESTABLISHED 1/4 POST.


B. Description of corner evidence found and/or method applied in restoring or reestablishing corner:

NO PHYSICAL CORNER FOUND
 FOUND E-2 AND 20" LOCUST WITH OLD FENCE ON TOP OF BLUFF 1292' NORTH OF E-2
 CALCULATED POSITION BY INTERSECTING NORTHERLY EXTENSION OF E-2 AND 20" LOCUST AND E-13 TO D-13 T2N, R13W. DID NOT SET CORNER DUE TO SWAMPY TERRAIN TRAVERSED 2796' EAST AND 2656' WEST.
 APPROVED BY THE ALLEGAN CO. REMON PEER GROUP JULY 11, 1995, AND IS ACCEPTED AS A CAREFUL AND FAITHFUL PERPETUATION OF THE POSITION OF THE ORIGINAL CORNER.

APPROVED REMONUMENTATION CORNER
 P.A. 345 OF 1990
 ALLEGAN COUNTY
 DATE APPROVED 7-11-95
 COUNTY REP. Donald R. Pitts, Jr.

C. Description of monument for corner and accessories established to perpetuate locating the position of the corner:

SEE BACK OF CERTIFICATE

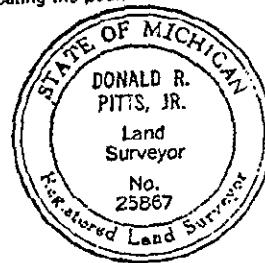

Signed by Donald R. Pitts, Jr. Date 30 August 1995
 Surveyor's Michigan License No. 25867

FORM APPROVED BY MICHIGAN STATE BOARD OF LAND SURVEYORS, JAN. 28, 1971
 REVISED MAY 14, 1975
 REVISED JAN., 1983

0005 PAGE 299

SHEET 1 OF 2


T. 2 N., R. 13 W.

32

33



NOT TO SCALE

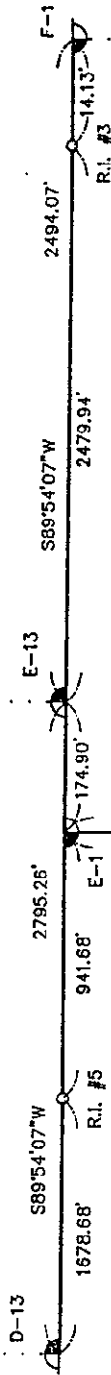

5

4

R.I. #5
STANDARD ALLEGAN CO. REMON 3/4"x36" REFERENCE
IRON W/ YELLOW CAP #23520
NAIL & REMON. TAG S. SIDE 20" PINE N40°W 45.51'
NAIL & REMON. TAG N. SIDE 8" MAPLE N60°W 27.06'
NAIL & REMON. TAG S.E. SIDE 8" TWIN MAPLE S45°W 35.00'
CENTER OF G.T.E. CABLE BOX N65°E 34.50'
CENTERLINE M-40 EAST 78'±

R.I. #4
STANDARD ALLEGAN CO. REMON 3/4"x36" REFERENCE
IRON W/ YELLOW CAP #23520
NAIL & REMON. TAG E. SIDE 20" LOCUST SOUTH 8.18'
NAIL & REMON. TAG W. SIDE 20" LOCUST NORTH 15.54'
NAIL & REMON. TAG N. SIDE 12" LOCUST N80°W 30.69'
NAIL & REMON. TAG W. SIDE 18" LOCUST N35°W 57.40'

R.I. #3
STANDARD ALLEGAN CO. REMON 3/4"x36" REFERENCE
IRON W/ YELLOW CAP #23520
NAIL & REMON. TAG N. SIDE 40" OAK S40°W 9.84'
NAIL & REMON. TAG N.E. SIDE 36" TWIN OAK N40°W 30.18'
NAIL & REMON. TAG N.W. SIDE 14" MAPLE N55°E 54.94'
NAIL & REMON. TAG S. SIDE 14" ASH N80°E 59.54'
EAST BANK KALAMAZOO RIVER WEST 14'±

1164.27'
N00°47'25"W

1301.09'
2465.36'

R.I. #4



T. 1 N., R. 13 W.