

LAND CORNER RECORDATION CERTIFICATE
Filing Requirement of Act 74, Mich. P.A. 1970

For corners in
Allegan

(County)

Located In:

Corner Code *≠*

1. Public Land Survey	T 1N R 13W	L-5
	T 1N R 13W	K-4
2. Property Controlling in Section	T R	
	T R	
	T R	
3. Miscellaneous Property in Sec.	S T R	
	S T R	

Register of Deeds Stamp & File Number

4. Lot No. _____, Recorded Plat _____
 5. Private Claims _____

	A	B	C	D	E	F	G	H	I	J	K	L	M
2	6	5	4	3	2	1							
3													
4	7	8	9	10	11	12							
5													
6	18	17	16	15	14	13							
7													
8	19	20	21	22	23	24							
9													
10	30	29	28	27	26	25							
11													
12	31	32	33	34	35	36							
13													

I, Gary C. Bilow, in a field survey on April 26, 1990, do hereby certify that under requirements of P.A. 74, Michigan P.A. of 1970, the corner points mentioned in lines 1 and 2 above were in conformance with regulations and rules therefore as required in the current manual of survey instructions of the United States Department of the Interior, Bureau of Land Management or by a decree of a Court of Law and/or that the corner points mentioned in lines 3, 4 and 5 above were in conformance with the rules of the Michigan Board of Land Surveyors or by a Decree of a Court of Law; established, re-established, monumented, re-monumented, recovered, found as expressed below:

NOTE: Not more than 4 corners, all in the same town and range, may be recorded on this certificate.

A. Description of original monument and accessories and/or subsequent restoration:

(L-5) Corner recorded by D.A. Ratekin, RLS 8781 L.2 P. 329 as found 1" iron. Rec. accessories: nail in NE root 22" maple South, 28.61; Nail in power pole N65°E, 72.80; Nail in 4" pine S60°E, 85.81; Nail in NW root of triple 12" Hackberry S60°W, 90.02' Corner also shown on survey by Ratekin Rec. L. 899, p. 489-490.

(K-4) Corner established by Lucius Lyon, G.L.O. Deputy Surveyor in 1831. Record accessories: Beech 9" S43W 33 links W. Oak 20' N63W 30 links. Found no record of perpetuation or subsequent restoration. Corner referred to in exception to deed Rec. L. 740, P. 296-297 (1967)

B. Description of corner evidence found and/or method applied in restoring or reestablishing corner:

(L-5) Found and accepted 1" iron bar in $\frac{1}{2}$ of E-W road. Bar is in accord with distance to K-5 as shown on survey noted above and with what is presumed to be a property corner (3/4" pipe) 33' North.

(K-4) Found and accepted "T" iron in N-S road at westerly extension of tree ROW. "T" iron is presumed to have been set by Consumers Power company surveyors CA. 1967. Found monumentation for exception to deed noted above are also "T" irons which were known to be set by Consumers Power Company. This type of monument does not appear to be popular with other surveyors in this locality. K-4 as found is in accord with parcel monumentation and record description.


C. Description of monument for corner and accessories established to perpetuate locating the position of the corner:

(L-5) Found 1" Iron bar
 North 33.15' Found 3/4" pipe with plug
 N73°E 72.65' Set rod spike in P/P
 S05°W 30.43' set spike and MDNR Tag in 30" Maple
 N21°W 53.29' set spike and MDNR tag in 7" W. Pine

(K-4) Found "T" Iron
 N30°E 159.9' Face of satellite dish post
 S84°E 60.48' set spike and MDNR tag in 12" walnut
 N06°W 132.23' set spike and MDNR tag in transformer pole
 S73°W 27.2' East Face of P/P at rod. spike

Signed by Gary C. Bilow

Surveyor's Michigan License No. 26453

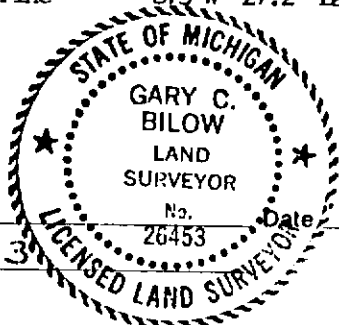

Date 8/1/90