

LAND CORNER RECORDATION CERTIFICATE
Filing Requirement of Act 74, Mich. P.A. 1970

For corners in

<u>Allegan</u> <small>(County)</small>	Located In:	Corner Code <i>≠#</i>
1. Public Land Survey	T <u>1N</u> R <u>13W</u>	<u>M-4</u>
	T _____ R _____	_____
	T _____ R _____	_____
	T _____ R _____	_____
2. Property Controlling in Section	S _____ T _____ R _____	_____
	S _____ T _____ R _____	_____
3. Miscellaneous Property in Sec.	S _____ T _____ R _____	_____
	S _____ T _____ R _____	_____

Register of Deeds Stamp & File Number

4. Lot No. _____, Recorded Plat _____
 5. Private Claims _____

	A	B	C	D	E	F	G	H	I	J	K	L	M
2	6	5	4	3	2	1							
3													
4	7	8	9	10	11	12							
5													
6	18	17	16	15	14	13							
7													
8	19	20	21	22	23	24							
9													
10	30	29	28	27	26	25							
11													
12	31	32	33	34	35	36							
13													

I, Gary C. Bilow, in a field survey on April 4, 19 90, do hereby certify that under requirements of P.A. 74, Michigan P.A. of 1970, the corner points mentioned in lines 1 and 2 above were in conformance with regulations and rules therefore as required in the current manual of survey instructions of the United States Department of the Interior, Bureau of Land Management or by a decree of a Court of Law and/or that the corner points mentioned in lines 3, 4 and 5 above were in conformance with the rules of the Michigan Board of Land Surveyors or by a Decree of a Court of Law; established, re-established, monumented, re-monumented, recovered, found as expressed below:

NOTE: Not more than 4 corners, all in the same town and range, may be recorded on this certificate.

A. Description of original monument and accessories and/or subsequent restoration:

(M-4) Corner originally established Dec. 1830 by Lucius Lyon and Sylvester Sibley, U.S. Deputy Surveyors who set post and noted following accessories: B. Ash 20", S6°W 55 L., Lynn 12", N45°W 10L. No explicit record of perpetuation. Allegan County Surveyor IRA Chichester notes in record: "survey for William Mon and others made Dec 5-6, 1866 on SE Fr'L 1/4 of Sec. S of river. Measured off from E. side for S. wilds a strip 32 45/100 rods in width running to river containing 21 acres of land"


B. Description of corner evidence found and/or method applied in restoring or reestablishing corner:

(M-4) Original monument and accessories obliterated. Noted remains of old N-S fence line both north and south of river and projected lines through them from M-3 and M-5 to establish corner location. Found no acceptable evidence of latitudinal position of original monument and therefore established corner at a point equidistant between M-3 and M-5 and in accord with direction of old fence lines.

C. Description of monument for corner and accessories established to perpetuate locating the position of the corner:

(M-4) Set 1/2" x 36" rebar encased in 4" dia. concrete cylinder capped with cast aluminum Mich. Dept. of Natural Resources tablet.

S14°W 177.07' set nail and MDNR tag in twin 8" maple
 S49°W 79.90 set nail and MDNR tag in maple clump
 S04°E 161.92' set nail and MDNR tag in 6" ash
 S40°W 65.62' set Rod spike as traverse point
 Set steel fence post within 1' of monument

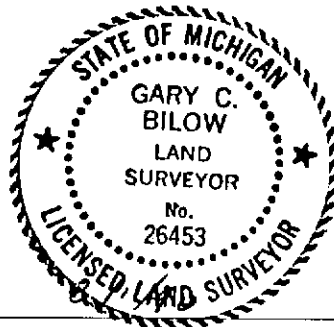

Signed by Gary C. Bilow Date _____
 Surveyor's Michigan License No. 26453