

**LAND CORNER RECORDATION CERTIFICATE**  
**Filing Requirement of Act 74, Mich. P.A. 1970**

For corners in

<u>Allegan</u> <small>(County)</small>	Located In:	Corner Code <i>##</i>
1. Public Land Survey	T <u>1N</u> R <u>13W</u>	<u>M-6</u>
	T <u>1N</u> R <u>13W</u>	<u>M-5</u>
	T _____ R _____	_____
	T _____ R _____	_____
2. Property Controlling in Section	S _____ T _____ R _____	_____
	S _____ T _____ R _____	_____
3. Miscellaneous Property in Sec.	S _____ T _____ R _____	_____
	S _____ T _____ R _____	_____
4. Lot No. _____, Recorded Plat _____		
5. Private Claims _____		

Register of Deeds Stamp & File Number

	A	B	C	D	E	F	G	H	I	J	K	L	M
2	6		5		4		3		2				
3													
4	7		8		9		10		11		12		
5													
6	18		17		16		15		14		13		
7													
8	19		20		21		22		23		24		
9													
10	30		29		28		27		26		25		
11													
12	31		32		33		34		35		36		
13													

I, Gary C. Bilow, in a field survey on March 6, 1990, do hereby certify that under requirements of P.A. 74, Michigan P.A. of 1970, the corner points mentioned in lines 1 and 2 above were in conformance with regulations and rules therefore as required in the current manual of survey instructions of the United States Department of the Interior, Bureau of Land Management or by a decree of a Court of Law and/or that the corner points mentioned in lines 3, 4 and 5 above were in conformance with the rules of the Michigan Board of Land Surveyors or by a Decree of a Court of Law, established, re-established, monumented, re-monumented, recovered, found as expressed below:

**NOTE: Not more than 4 corners, all in the same town and range, may be recorded on this certificate.**

A. Description of original monument and accessories and/or subsequent restoration:

- (M-6) County surveyor records Ca. 1880 state " 1/4 post on E line section a large irregular stone, a + on top at corner.
- (M-5) Corner recorded by D.A. Ratekin, LS #8781 Sept. 30, 1974, as set 1" iron over found stone, stake, and iron. Accessories: nail and washer in pole #143 N25°E, 50.82'; nail in 28" maple, N45°E, 69.23'; nail in 28" maple S25°W, 70.28'.


B. Description of corner evidence found and/or method applied in restoring or reestablishing corner:

- (M-6) Found and accepted 3/4" iron bar with cap #8781 in centerline of N-S gravel road 5" below road surface on easterly extension of old wire fence and stone row.
- (M-5) Found and accepted 1" iron bar. Ratekins accessories to Maples overgrown but appear to check.

C. Description of monument for corner and accessories established to perpetuate locating the position of the corner:

- (M-6) Found 3/4" iron bar with cap #8781 North 35.70' 4" dia. conc. monument with MDNR cap at W 1/4 cor sec. 18 T 1N - R 12W S65°E 23.92" set nail and MDNR tag N face 8" Locust. S25°E 25.98' set nail and MDNR tag W face 8" Locust. S85°W 14.89' set nail and MDNR tag S face 7" Locust
- (M-5) Found 1" iron bar S10°W 151.30' set nail and MDNR tag E. face p/p S30°W 70.47' set nail and MDNR tag E face 32" maple S76°W 97.32' set nail and MDNR tag SE face 15" Walnut. North 37.62 4" Dia. MDNR conc. monument at NW cor. sec 18 T 1N - R 12W

Signed by Gary C. Bilow  
 Surveyor's Michigan License No. 26453

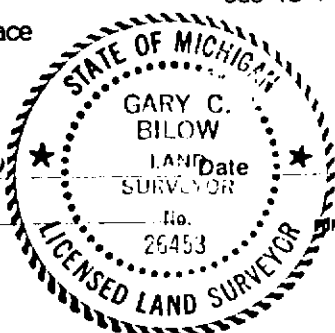

FORM APPROVED BY MICHIGAN STATE BOARD OF LAND SURVEYORS, JAN. 28, 1971  
 REVISED MAY 14, 1975  
 REVISED JAN., 1983