

LAND CORNER RECORDATION CERTIFICATE
Filing Requirement of Act 74, Mich. P.A. 1970

For corners in
Allegan

(County)	Located In:	Corner Code <i>≠</i>
1. Public Land Survey	T <u>1N</u> R <u>13W</u>	<u>M-7</u>
	T _____ R _____	_____
	T _____ R _____	_____
	T _____ R _____	_____
2. Property Controlling in Section	S _____ T _____ R _____	_____
	S _____ T _____ R _____	_____
3. Miscellaneous Property in Sec.	S _____ T _____ R _____	_____
	S _____ T _____ R _____	_____

Register of Deeds Stamp & File Number

4. Lot No. _____, Recorded Plat _____
 5. Private Claims _____

	A	B	C	D	E	F	G	H	I	J	K	L	M
2	6	5	4	3	2	1							
3													
4	7	8	9	10	11	12							
5													
6	18	17	16	15	14	13							
7													
8	19	20	21	22	23	24							
9													
10	30	29	28	27	26	25							
11													
12	31	32	33	34	35	36							
13													

I, Gary C. Bilow, in a field survey on March 6, 19 90, do hereby certify that under requirements of P.A. 74, Michigan P.A. of 1970, the corner points mentioned in lines 1 and 2 above were in conformance with regulations and rules therefore as required in the current manual of survey instructions of the United States Department of the Interior, Bureau of Land Management or by a decree of a Court of Law and/or that the corner points mentioned in lines 3, 4 and 5 above were in conformance with the rules of the Michigan Board of Land Surveyors or by a Decree of a Court of Law, established, re-established, monumented, re-monumented, recovered, found as expressed below:

NOTE: Not more than 4 corners, all in the same town and range, may be recorded on this certificate.

A. Description of original monument and accessories and/or subsequent restoration:


(M-7) Corner originally established Dec. 1830 by Lucius Lyon and Sylvester Sibley, G.L.O. Deputy Surveyors who set post and noted following accessories: Lynn 26" S28°W, 37 links, ash 20" N56°W, 26 links. No record of subsequent restoration.

B. Description of corner evidence found and/or method applied in restoring or reestablishing corner:

(M-7) Found and accepted 1/2" iron pipe 5" below gravel surface at record falling south of S.W. corner section 18 T 1N - R 12W.

C. Description of monument for corner and accessories established to perpetuate locating the position of the corner:

(M-7) Found 1/2" iron pipe N30°W 47.51' set nail and MDNR Tag W. Face 15" Elm North 50.81 found 1/2" bar with cap 8781 at S.W. corner section 18 T 1N - R 12W S60°W 39.82 set nail and MDNR tag S.E. face 6" Triple Hickory South 55.60 set nail and MDNR tag W face 7" Silver Maple

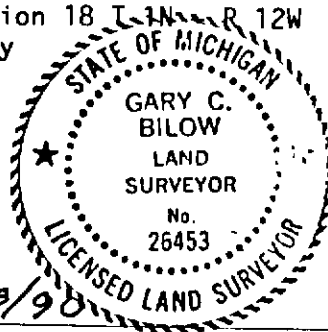

Signed by Gary C. Bilow Date 8/28/90
 Surveyor's Michigan License No. 26453