


"OTHER" CORNER MAP

CHESHIRE

T. 14N.-R. 14W.

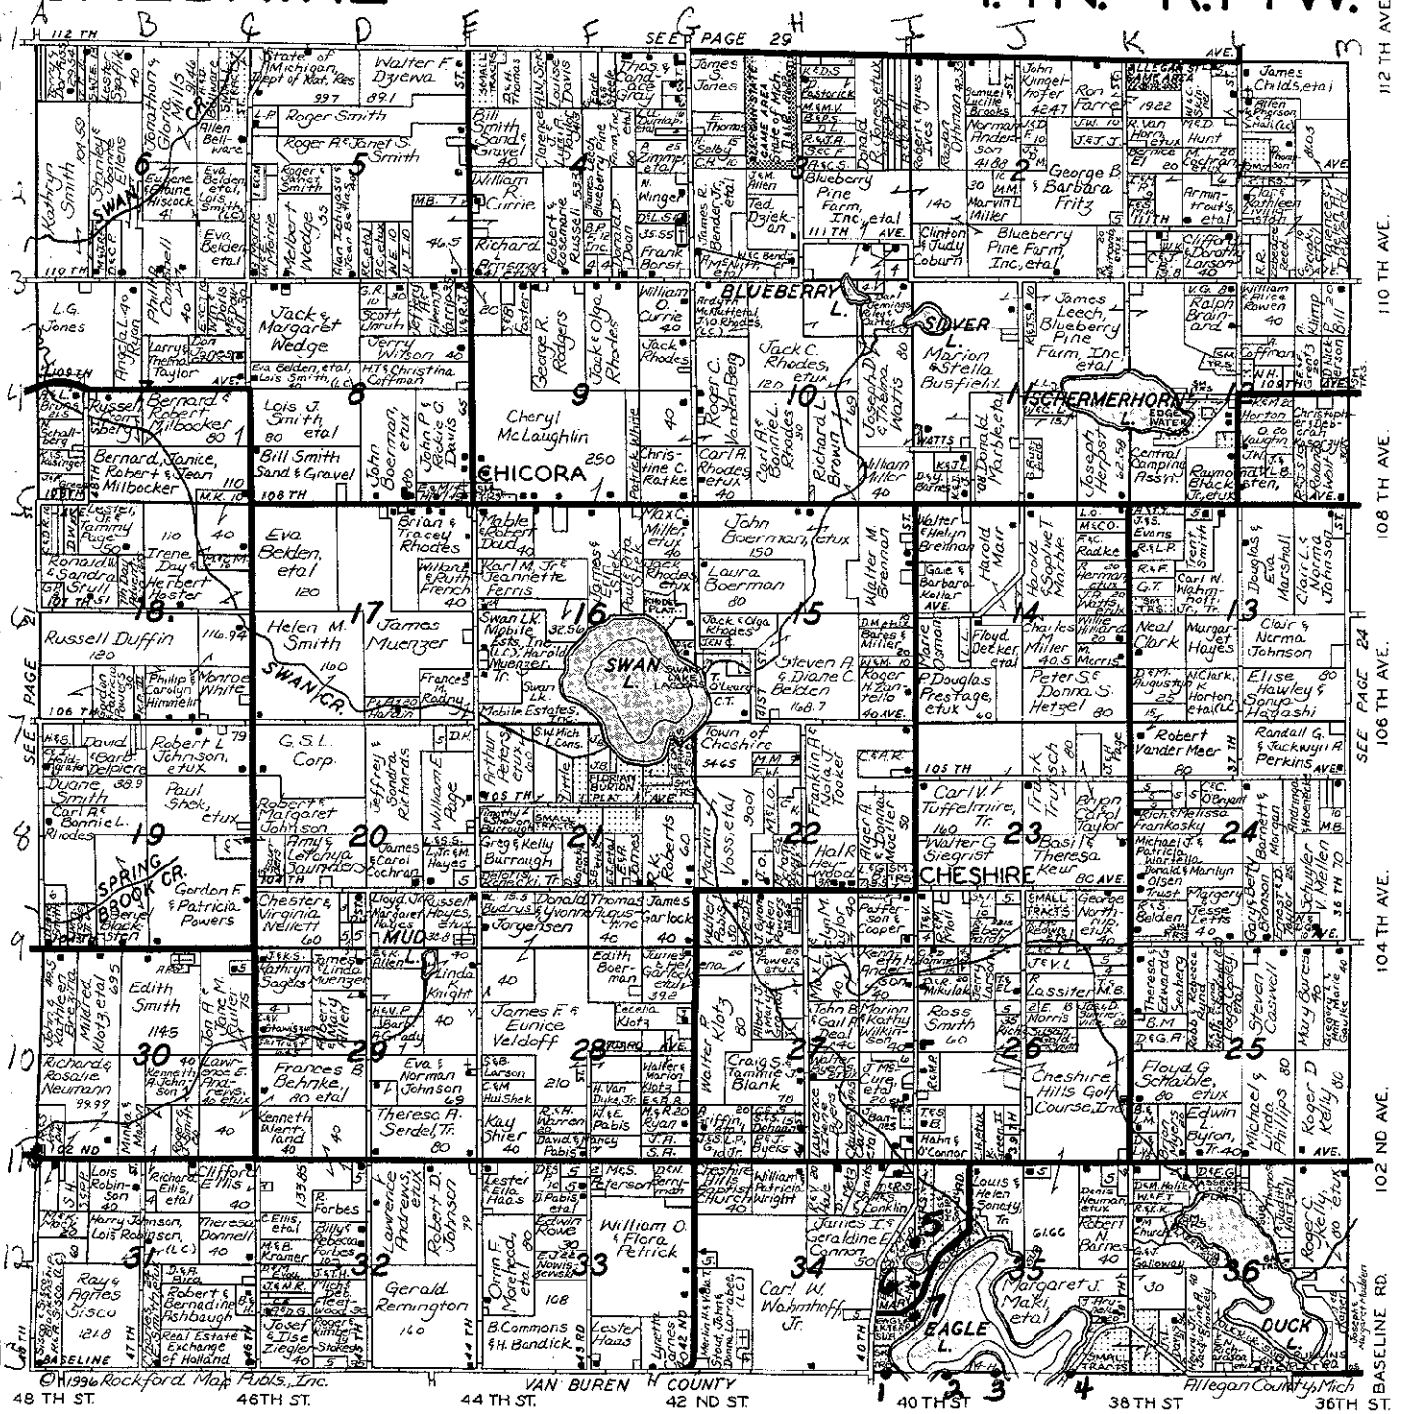

1997 = #1, #2, #3, #4 1998 = #5, #6, #7

Cheshire Hills
GOLF COURSE INC.

Newly Remodeled
Enlarged Clubhouse

- 27 Hole Golf Course
- Excellent Driving Range Facility
- Restaurant
- Pro Shop
- Golf Instructions Available
- Lounge

For More Information Call: 673-2882 or 521-3490
2 1/2 Miles West of M-40 (Merson Corners) on 102nd Avenue

SWAN LAKE STORE

Your Store With Everything
GROCERIES • DELI • CAMPING

521-6510
658 - 42nd Street

All Forms of Insurance

GEORGE B. FRITZ
INS. AGENCY

207 South State Street
Gobles, Michigan

Phone:
628-2861 or 673-7361

Life - Fire - Auto
Accident - Liability - Crop