REMONUMENTATION

APR 2 5 1995

COMMISSION

ALLEGAN COUNTY REMONUMENTATION
LAND CORNER RECORDATION CERTIFICATE
Filing Requirement of Act 74, Mich. P.A. 1970

For corners in

ALLEGAN (County)

	Located In:	Corner Code ##
1. Public Land Survey	T 1N R 14W	C-1, Cheshire
	T ___ R ___	
	T ___ R ___	
	T ___ R ___	
2. Property Controlling	S ___ T ___ R ___	
in Section	S ___ T ___ R ___	
3. Miscellaneous	S ___ T ___ R ___	
Property in Sec.	S ___ T ___ R ___	

1994 DEC 16 AM 9:53
FILED
REGISTER OF DEEDS
ALLEGAN COUNTY, MICH.

Register of Deeds Stamp & File Number

4. Lot No. _____ , Recorded Plat _____
5. Private Claims _____

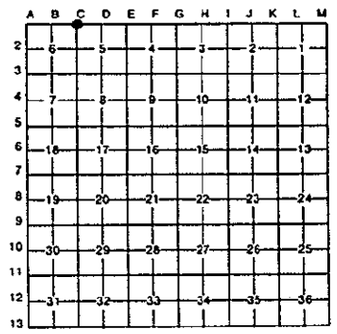

I, Donald R. Pitts Jr. in a field survey on August 19 , 19 94 , do hereby certify that under requirements of P.A. 74, Michigan P.A. of 1970, the corner points mentioned in lines 1 and 2 above were in conformance with regulations and rules therefore as required in the current manual of survey instructions of the United States Department of the Interior, Bureau of Land Management or by a decree of a Court of Law and/or that the corner points mentioned in lines 3, 4 and 5 above were in conformance with the rules of the Michigan Board of Land Surveyors or by a Decree of a Court of Law; established, re-established, monumented, re-monumented, recovered, found as expressed below:

NOTE: Not more than 4 corners, all in the same town and range, may be recorded on this certificate.

A. Description of original monument and accessories and/or subsequent restoration:

G.L.O-Intersect N. Boundary 115 Links E. of post & Set Post Cor., Section, 5 & 6.
Lynn 12" S.45°W. 10 Links
B. Ash 7" S.25°E. 15 Links
1904-Allegan Co. Surveyor Notes
Stake & Stone/No Witnesses
1973-Allegan Co. Surveyor Donald A. Ratekin/L.C.R.C. Liber 2, Page 252
Found 5/8" Iron
15" Ash S.60°W. 81.15' 15" Sycamore N. 61.6'
20" Maple S.50°E. 64.8' 10" Ash N.50°W. 86.6'

B. Description of corner evidence found and/or method applied in restoring or reestablishing corner:

Found 5/8" Iron
Pulled Iron and set Standard Allegan Co. Remon. 3/4"X24" Iron with Red Cap 23520.
Traversed 2605' East & 2639' West
Approved by the Allegan Co. Remon. Peer Group on April 12, 1994, and is accepted as a careful and faithful perpetuation of the position of the original corner.

APPROVED REMONUMENTATION CORNER
P.A. 345 OF 1990
ALLEGAN COUNTY
DATE APPROVED 4-12-94
COUNTY REP. Rick L. Van Ostrand

C. Description of monument for corner and accessories established to perpetuate locating the position of the corner:

Standard Allegan Co. Remon. 3/4"X24" Iron with red cap 23520
C-13, T.2N., R.14W., Standard Allegan Co. Remon. 3/4"X24"
Iron with red cap 23520 West 75.90'.
Nail & Allegan Co. Remon. tag in top of wood guard post S.60°E. 37.78'
" " " " " " " " " " " " N.65°E. 38.55'
" " " " " " " " " " " " N.40°W. 23.10'

STATE OF MICHIGAN
DONALD R. PITTS, JR.
Land Surveyor
No. 25867
Registered Land Surveyor

Signed by Donald R. Pitts Jr. Date 30 August 1994
Surveyor's Michigan License No. 25867

FORM APPROVED BY MICHIGAN STATE BOARD OF LAND SURVEYORS, JAN. 28, 1971
REVISED MAY 14, 1975
REVISED JAN., 1983

LIBER 0005 PAGE 008