

RE

MAR 07 2000

ALLEGAN COUNTY REMONUMENTATION
LAND CORNER RECORDATION CERTIFICATE
Filing Requirement of Act 74, Mich. P.A. 1970

FILED

LIBR00007 PAGE 176

00 FEB -1 11 8:36

Jayne A. ...

REGISTER OF DEEDS
ALLEGAN COUNTY, MICH.

Register of Deeds Stamp & File Number

For corners in SECTION

Allegan
(County)

Located In: Cheshire Corner Code #K-12
(Township)

	T	1N	R	14W	E1/4 COR SEC 35
1. Public Land Survey	T		R		
	T		R		
	T		R		
	T		R		
2. Property Controlling in Section	S		T		R
	S		T		R
3. Miscellaneous Property in Sec.	S		T		R
	S		T		R

4. Lot No. _____, Recorded Plat _____
5. Private Claims _____

I, Robert E. Lemke, surveyor, in a field survey on March 13, 1998 do hereby state that under requirements of P.A. 74, Michigan P.A. of 1970, the corner points mentioned in lines 1 and 2 above were in conformance with regulations and rules therefore as required in the current manual of survey instructions of the United States Department of the Interior, Bureau of Land Management or by a decree of a Court of Law and /or that the corner points mentioned in lines 3, 4 and 5 above were in conformance with the rules of the Michigan Board of Land Surveyors or by a Decree of a Court of Law; established, reestablished, monumented, recovered, found as expressed below:

	A	B	C	D	E	F	G	H	I	J	K	L	M
1													
2	6			5		4		3		2		1	
3													
4	7			8		9		10		11		12	
5													
6	18			17		16		15		14		13	
7													
8	19			20		21		22		23		24	
9													
10	30			29		28		27		26		25	
11													
12	31			32		33		34		35		36	
13													

NOTE: Not more than 2 corners, all in the same town and range, may be recorded on this certificate.

A. Description of original monument and accessories and/or subsequent restoration:

K-12 GLO	County Survey Notes	L.C.R.C	
Act 132 Survey			
Set 1/4 post	Sept. 29, 1880	L02-P415 - D. A. Ratekin	L840-P463
Beech 5" S13°E 13 lks	"Stone"	11/08/74 Act 132 Survey(s)	D. A. Ratekin & Assoc.
B. Ash 16" N10°W 18 lks		found 1" iron	Same wit's. as L.C.R.C. L02-P415
Calvin Britain May 1831		FE Cor E 20.1'	
		Nail in N side P. Pole S75°E 74.46'	
		Nail in SW side 24" Hickory S40°E 44.12'	
		Nail in N side 22" Maple S85°E 53'	

Witness Card
Mitchell Surveys, 10/93
Same wit's. as L.C.R.C. L02-P415

B. Description of corner evidence found and/or method applied in restoring or reestablishing corner:
K-12 Found 1 in. iron bar, no previous witnesses remaining.

And is accepted as a careful and faithful perpetuation of the position of the original corner.

C. Description of monument for corner and accessories established to perpetuate locating the position of the corner:
K-12 Friday, March 13th, 1998 - In existing monument box, 3.0 ft. W of centerline of 38th Street, 1/2 mile S. of 102nd Avenue:
Set standard Allegan County monument (3/4" x 24" steel rod w/red cap #23520). Centerline of 38th is 3' east.
Nail w/tag*, N. side of power pole - N 90 - degrees W, 74.12 ft.
Nail w/tag*, N. side of 10 in. Elm - S 75 - degrees W, 52.02 ft.
Nail w/tag*, W. side of 14 in. Maple - N 40 degrees E, 80.73 ft.
Nail w/tag*, S. side of 6 in. Oak - S 75 degrees E, 32.20 ft.
Nail w/tag*, SW side of 24 in. Hickory - S 30 degrees E, 77.38 ft.
Found iron pipe - S 70 degrees E, 36.80 ft.

*Set 16D double-headed nail w/Allegan County Remonumentation Tag.
Field book 2, Page 32

APPROVED REMONUMENTATION CORNER
P.A.345 OF 1990
ALLEGAN COUNTY


DATE APPROVED _____
COUNTY REP. _____

Signed by *Robert E. Lemke*

Date 4/13/99

For SDI CONSULTANT

Surveyor's Michigan License No. 40160

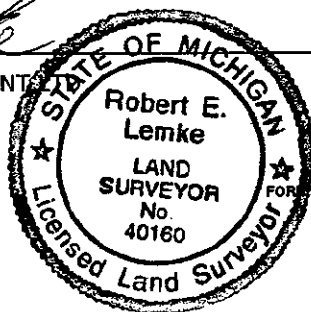

E:\1998\CORR\AlegCoRemon\Ches.T1N14W\K-12-1
APPROVED BY MICHIGAN STATE BOARD OF PROFESSIONAL SURVEYORS
JAN. 28, 1971 REVISED MAY 14, 1975
REVISED JAN., 1993
REVISED OCT., 1995