

LAND CORNER RECORDATION CERTIFICATE
Filing Requirement of Act 74, Mich. P.A. 1970

For corners in
Allegan
(County)

Located In:

Corner Code ##

1. Public Land Survey	T	<u>1N</u>	R	<u>14W</u>	<u>G6</u>
	T	<u>1N</u>	R	<u>14W</u>	<u>MC S. of G6</u>
	T	_____	R	_____	_____
	T	_____	R	_____	_____
2. Property Controlling in Section	S	_____	T	_____	_____
	S	_____	T	_____	_____
3. Miscellaneous Property in Sec.	S	_____	T	_____	_____
	S	_____	T	_____	_____

Register of Deeds Stamp & File Number

4. Lot No. _____, Recorded Plat _____
 5. Private Claims _____

	A	B	C	D	E	F	G	H	I	J	K	L	M
2	6		5		4		3		2		1		
3													
4	7		8		9		10		11		12		
5													
6	18		17		16		15		14		13		
7													
8	19		20		21		22		23		24		
9													
10	30		29		28		27		26		25		
11													
12	31		32		33		34		35		36		
13													

I, Gary C. Bilow, in a field survey on February 02, 1993, 19_____, do hereby certify that under requirements of P.A. 74, Michigan P.A. of 1970, the corner points mentioned in lines 1 and 2 above were in conformance with regulations and rules therefore as required in the current manual of survey instructions of the United States Department of the Interior, Bureau of Land Management or by a decree of a Court of Law and/or that the corner points mentioned in lines 3, 4 and 5 above were in conformance with the rules of the Michigan Board of Land Surveyors or by a Decree of a Court of Law; established, re-established, monumented, re-monumented, recovered, found as expressed below:

NOTE: Not more than 4 corners, all in the same town and range, may be recorded on this certificate.

A. Description of original monument and accessories and/or subsequent restoration:


G-6: Post established by U.S. Deputy Surveyor C. Britain in 1831 - accessories: Beech 15, S54E 23 links and Elm 12, S77W 18 links. Corner recorded under Act 74 PA 1970 by D. Ratekin (PS #8781) on November 14, 1973 in Liber 2 Page 192 - "Couldn't locate corner - Set 1" iron using remaining witnesses - accessories: 4" Ash (P.K. Nail) East 34.06' and Power Pole (P.K. Nail) S40W 66.72'." Corner referenced to on the Plat of Swan Lake Lagoons dated November 1956.
 MC S. of G6: Post established by U.S. Deputy Surveyor C. Britain in 1831 - accessories: White Ash 6, N9W 12 links and Sycamore 8, N46E 42 links.

B. Description of corner evidence found and/or method applied in restoring or reestablishing corner:

G-6: Found 3/4" Iron bar and one of Ratekin's witnesses. Accepted this Iron bar as the best evidence of the original GLO corner.
 MC S. of G6: Found 3/4" Iron pipe 1126.26 feet South of corner G-6 to be reasonable and consistent to the GLO distance of 1122 feet. Accepted as the best evidence of the original GLO post.

C. Description of monument for corner and accessories established to perpetuate locating the position of the corner:

G-6: Found 3/4" Iron bar N23E 70.96', Nail & Tag in 5" Elm S78E 41.49', Nail & Tag in Ash cluster S48W 66.62', Nail & Tag in Power pole Centerline North-South dirt road	MC S. of G6: Found 3/4" Iron pipe and replaced with 1/2" x 36" rebar encased in 4" diameter concrete cylinder and capped with a cast aluminum Michigan Department of Natural Resources Tablet S50E 49.40', Spike in 36" Maple N79W 29.58', Nail & Tag in 10" Elm N9W 59.44', Nail & Tag in 28" Maple N18E 80.53', Nail & Tag in 19" Maple
--	---

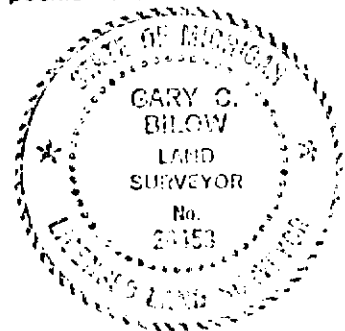

Signed by Gary C. Bilow Date 2/16/93
 Surveyor's Michigan License No. 26453