

APR 29 1999

ALLEGAN COUNTY REMONUMENTATION

SECTION

LAND CORNER RECORDATION CERTIFICATE

Filing Requirement of Act 74, Mich. P.A. 1970

For corners in

- .....ALLEGAN ..... Located in: LEE ..... Township  
Corner Code #
- Public Land Survey T..1..N R..15 W.....C-13.....  
T..... R..... SW COR, SEC 32
  - Property Controlling S..... T..... R.....  
in Section S..... T..... R.....
  - Miscellaneous S..... T..... R.....  
Property in Sec. S..... T..... R.....
  - Lot No. ...., Recorded Plat .....
  - Private Claims.....

FILED

1/28/1999 2:44:39 PM

JOYCE A. WATTS  
REGISTER OF DEEDS  
ALLEGAN COUNTY, MICH

Register of Deeds Stamp & File Number


LIBERO 006 PAGE 58

I, .... **George J. Mitchell**....., in a filed survey on ...**10/26 thru 11/07/98**.....  
do hereby certify that under requirements of P.A. 74, Michigan P.A. of 1970, the corner  
points mentioned in lines 1 and 2 above were in conformance with regulations and rules  
therefore as required in the current manual of survey instructions of the United States  
Department of the Interior, Bureau of Land Management or by decree of a Court of Law  
and/or that the corner points mentioned in lines 3, 4, and 5 above were in conformance  
with the rules of the Michigan Board of Land Surveyors or by decree of a Court of Law;  
established, re-established, monumented, re-monumented, recovered, found as expressed  
below:

NOTE: Not more than 4 corners, all in the same town & range, may be recorded  
on this certificate.

A. Description of original monument and accessories and/or subsequent restoration:

C-13) W. BROOKFIELD 1827 WEST ON SOUTH SIDE OF SECTION 32  
40.00 CHAINS SET POST  
80.00 CHAINS SET POST  
BEECH 10 N72W 50 LKS  
BEECH 9 N26-1/4E 24 LKS

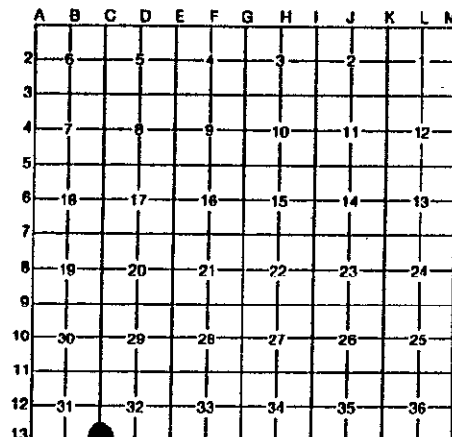

GLO NOTES FROM ORIGINAL TOWNSHIP SURVEY OF TOWN 1 SOUTH, RANGE 15 WEST SHOWS A JOG DISTANCE  
OF 3.96 CHAINS (261.36 FEET) EAST FROM NW CORNER OF SEC. 6 T1S, R15W TO SW CORNER OF SECTION 32,  
T1N, R15W.

B. Description of corner evidence found and/or method applied in restoring or reestablishing corner:

C-13) FOUND 1" PIPE LOCATED 261.35 FEET EAST OF VAN BUREN COUNTY MONUMENT AT NW CORNER OF  
T1S, R15W. THE FOUND PIPE, THE V.B. MONUMENT AND MONUMENT AT THE 3/4 POST OF SECTION 31,  
T1N, R15W ARE ON A STRIGHT LINE. THE 1" PIPE IS ACCEPTED AS A CAREFUL AND FAITHFUL  
PERPETUATION OF THE POSITION OF THE ORIGINAL CORNER.

THIS CORNER WAS APPROVED BY THE ALLEGAN COUNTY SURVEYORS PEER GROUP ON NOVEMEBR 10, 1998

C. Description of monument for corner and accessories established to perpetuate locating the position of the corner:

C-13) SOUTHWEST CORNER, SECTION 32, TOWN 1 NORTH, RANGE 15 WEST  
REMOVED 1" PIPE AND SET 3/4" X 36" IRON PIN WITH ALLEGAN CO. REMON CAP.

A.C. REMON TAG & NAIL IN SE. SIDE OF 60" MAPLE	AZ.	080°	138.78 FEET
A.C. REMON TAG & NAIL IN NE SIDE OF 12" MAPLE	AZ.	135°	68.20 FEET
A.C. REMON TAG & NAIL IN NW SIDE OF 14" MAPLE	AZ.	185	71.90 FEET
A.C. REMON TAG & NAIL IN NE SIDE OF 12" ASH	AZ.	280°	81.80 FEET
NW CORNER SEC 6, T1S, R15W	AZ.	270°	261.35 FEET

CORNER IS 10 FEET EAST OF THE CENTER OF "T" INTERSECTION

C-13 TO B-13 MEASURED 2633.00 FEET

APPROVED REMONUMENTATION CORNER  
P.A. 345 OF 1990  
ALLEGAN COUNTY  
DATE APPROVED Nov. 10, 1998  
COUNTY REP. [Signature]

Signed by George J. Mitchell  
Surveyor's Michigan License No. ....19618.....

Date Nov. 11, 1998

