

MAR 07 2000

ALLEGAN COUNTY REMONUMENTATION
LAND CORNER RECORDATION CERTIFICATE

Filing Requirement of Act 74, Mich. P.A. 1970

SECTION

For corners in

ALLEGAN COUNTY..... Located in: LEE Township
Corner Code #

- 1. Public Land Survey T.1 N. R.15 W.G-6.....
T..... R..... W1/4 POST SEC. 15
- 2. Property Controlling S..... T..... R.....
in Section S..... T..... R.....
- 3. Miscellaneous S..... T..... R.....
Property in Sec. S..... T..... R.....
- 4. Lot No., Recorded Plat
- 5. Private Claims.....

George J. Mitchell
REGISTER OF DEEDS
ALLEGAN COUNTY


00 FEB - 1 11 8 41

FILED

ALLEGAN COUNTY / PAGE 326

Register of Deeds Stamp & File Number

I, George J. Mitchell, in a field survey on October 5, 1999, do hereby certify that under requirements of P.A. 74, Michigan P.A. of 1970, the corner points mentioned in lines 1 and 2 above were in conformance with regulations and rules therefore as required in the current manual of survey instructions of the United States Department of the Interior, Bureau of Land Management or by decree of a Court of Law and/or that the corner points mentioned in lines 3, 4, and 5 above were in conformance with the rules of the Michigan Board of Land Surveyors or by decree of a Court of Law; established, re-established, monumented, re-monumented, recovered, found as expressed below:

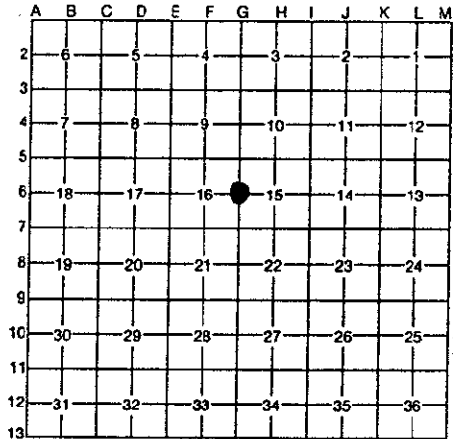

NOTE: Not more than 4 corners, all in the same town & range, may be recorded on this certificate.

A. Description of original monument and accessories and/or subsequent restoration:

- 1. C. BRITAIN D.S. 1831 SET POST
PINE 8 S69W 26LKS
PINE 10 N32E 8 LKS
- 2. D. RATEKIN D.S. CARD FILE 1' IRON
STREET SIGN ESE 31.95'
POWER POLE NE 80.05'
6" MAPLE EAST 32.3'
- 2. OLD NOTES (NO DATE) STAKE & STONE

B. Description of corner evidence found and/or method applied in restoring or reestablishing corner:

FOUND 1" IRON BAR FROM ITEM 2 OF CORNER HISTORY, AND IS ACCEPTED AS A CAREFUL AND FAITHFUL PERPETUATION OF THE POSITION OF THE ORIGINAL CORNER.

SET ALLEGAN COUNTY STANDARD 3/4" BY 36" IRON PIN WITH REMON CAP.

THIS CORNER WAS APPROVED BY THE ALLEGAN COUNTY SURVEYORS PEER GROUP ON JUNE 8, 1999
FOUND 1" IRON BAR

C. Description of monument for corner and accessories established to perpetuate locating the position of the corner:

WEST QUARTER POST OF SECTION 15, TOWN 1 NORTH, RANGE 15 WEST

- A.C. REMON TAG & NAIL IN NORTH SIDE OF 15" OAK AZ 090° 32.08 FEET
- A.C. REMON TAG & NAIL IN NORTHWEST SIDE OF 14" OAK AZ 045° 81.10 FEET
- SOUTH FACE OF A 4 FOOT ABOVE GROUND CONCRETE MONUMENT AZ 000° 33.35 FEET
- SW CORNER OF A 4 FOOT ABOVE GROUND CONCRETE MONUMENT AZ 290° 174.00 FEET
- CENTER OF GRAVEL ROAD TO THE SOUTH EAST 23'
- CORNER LINES UP WITH CENTER OF ROAD TO WEST

APPROVED REMONUMENTATION CORNER
P.A. 345 OF 1990
ALLEGAN COUNTY
DATE APPROVED JUNE 8, 1999
COUNTY REP. George J. Mitchell

Signed by George J. Mitchell Date 10/28/99

Surveyor's Michigan License No.19618.....

