

RECORDED

MAR 07 2000

ALLEGAN COUNTY REMONUMENTATION
LAND CORNER RECORDATION CERTIFICATE

For corners in

Filing Requirement of Act 74, Mich. P.A. 1970

ALLEGAN COUNTY..... Located in: LEE..... Township
Corner Code #

- 1. Public Land Survey T.1 N. R.15 W. H-4.....
T..... R..... CENTER, SEC. 10
- 2. Property Controlling S..... T..... R.....
in Section S..... T..... R.....
- 3. Miscellaneous S..... T..... R.....
Property in Sec. S..... T..... R.....
- 4. Lot No., Recorded Plat
- 5. Private Claims.....

George J. Mitchell
REGISTER OF DEEDS
ALLEGAN COUNTY, MICH.


00 FEB - 1 AM 8:42

FILED

1000007 PROCS 30

Register of Deeds Stamp & File Number

I, **George J. Mitchell**....., in a field survey on ...**October 7, 1999**.....
do hereby certify that under requirements of P.A. 74, Michigan P.A. of 1970, the corner
points mentioned in lines 1 and 2 above were in conformance with regulations and rules
therefore as required in the current manual of survey instructions of the United States
Department of the Interior, Bureau of Land Management or by decree of a Court of Law
and/or that the corner points mentioned in lines 3, 4, and 5 above were in conformance
with the rules of the Michigan Board of Land Surveyors or by decree of a Court of Law;
established, re-established, monumented, re-monumented, recovered, found as expressed
below:

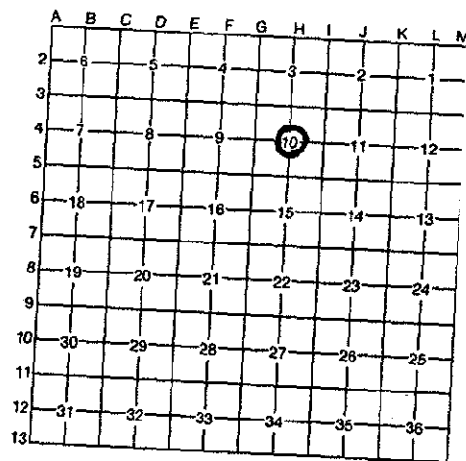

A. Description of original monument and accessories and/or subsequent restoration:
H-4

SEE SHEET 2 OF 2 FOR CORNER HISTORY

B. Description of corner evidence found and/or method applied in restoring or reestablishing corner:

FOUND 1" IRON BAR IN MONUMENT BOX FROM ITEMS 3 THROUGH 7 OF CORNER HISTORY. FOUND CORNER IS
LOCATED 4.00 FEET WEST OF THE NORTH AND SOUTH QUARTER LINE AND 0.33 FEET NORTH OF THE
EAST AND WEST QUARTER LINE.

DROVE 1" IRON BAR DOWN AND SET ALLEGAN COUNTY 3/4" BY 12" IRON PIN WITH REMON CAP
ON TOP OF 1" IRON.

THIS POSITION NOT ESTABLISHED BY ORIGINAL GOVERNMENT SURVEYORS. THIS MONUMENT IS ACCEPTED
AS THE BEST AVAILABLE EVIDENCE OF THE POSITION OF THE CORNER.

THIS CORNER WAS APPROVED BY THE ALLEGAN COUNTY SURVEYORS PEER GROUP ON OCTOBER 12, 1999

C. Description of monument for corner and accessories established to perpetuate locating the position of the corner:

CENTER OF SECTION 10, TOWN 1 NORTH, RANGE 15 WEST

- A.C. REMON TAG & NAIL IN NORTHWEST SIDE OF 16" OAK
- A.C. REMON TAG & NAIL IN SOUTHWEST SIDE OF 16" OAK
- A.C. REMON TAG & NAIL IN SOUTHEAST SIDE OF 16" PINE
- A.C. REMON TAG & NAIL IN SOUTHWEST SIDE OF POWER POLE
- CENTER OF 109TH AVE
- H-4 TO H-3 MEASURED 2652.60 FEET
- H-4 TO G-4 MEASURED 2629.97 FEET
- H-4 TO I-4 MEASURED 2622.61 FEET.

- AZ. 040° 74.70 FEET
- AZ. 290° 86.25 FEET
- AZ. 225° 90.25 FEET
- AZ. 135° 49.80 FEET
- AZ. 180° 1 FOOT

APPROVED REMONUMENTATION CORNER
P.A. 345 OF 1990
ALLEGAN COUNTY
DATE APPROVED OCT. 12, 1999
COUNTY REP. George J. Mitchell

Signed by George J. Mitchell Date 10/28/99

Surveyor's Michigan License No.19618.....



MAR 07 2000

SECTION

GOVERNMENT CORNER HISTORY

CENTER OF SECTION 10
TOWN 1 NORTH, RANGE 15 WEST

H-4

1. NOTE SET IN ORIGINAL GOVERNMENT SURVEY
2. OLD NOTES MCDOUGHAL
STAKE
10" OAK SE 49.2'
10' OAK SW 58'
2632' WEST TO W1/4 POST
2648' NORTH TO N1/4 POST
2624' EAST TO E1/4 POST
3. D. MIDDLETON 1971
L.C.R.C. L. 001, P. 163
1-1/4" IRON BAR IN MON BOX
IRON IS 1.0' NORTH OF ROAD CENTERLINE
POWER POLE S45E 49.70'
STREET SIGN S45W 53.56'
T.C. BOX POST N45E 39.30'
IRON IS 5.5' EAST OF ROAD CENTERLINE NORTH-SOUTH
4. D. RATEKIN 1972
SAME AS L.C.R.C.
5. G. MITCHELL 1980
FD IRON BAR IN MON BOX
STREET SIGN SW 56.5'
TELE. C. BOX NE 39.0'
TELE. POLE SE 49.5'
6. S. PITTS 1994
IRON
NO WITNESSES
H-3 TO H-4 SHOWS 2652.54'
7. R. MOORED 1997
FD IRON IN MON BOX
NO WITNESSES
8. G. MITCHELL 1999
FD. 1" IRON BAR IN MON BOX
H-4 TO N1/4 POST 2652.60'
H-4 TO W/4 POST 2629.97'
H-4 TO E1/4 POST 2622.61'

LIBR0007 MAR31