

RECORDED

MAR 07 2000

ALLEGAN COUNTY REMONUMENTATION  
LAND CORNER RECORDATION CERTIFICATE

SECTION

Filing Requirement of Act 74, Mich. P.A. 1970

For corners in

ALLEGAN COUNTY..... Located in: LEE Township  
Corner Code #

- 1. Public Land Survey T.1 N. R.15 W. H-6  
T..... R..... CENTER, SEC. 10
- 2. Property Controlling S..... T..... R.....  
in Section S..... T..... R.....
- 3. Miscellaneous S..... T..... R.....  
Property in Sec. S..... T..... R.....
- 4. Lot No. ...., Recorded Plat .....
- 5. Private Claims.....

REGISTER OF DEEDS  
ALLEGAN COUNTY

00 FEB -1 AM 8:42

FILED

Register of Deeds Stamp & File Number

I, George J. Mitchell, in a field survey on October 7, 1999 do hereby certify that under requirements of P.A. 74, Michigan P.A. of 1970, the corner points mentioned in lines 1 and 2 above were in conformance with regulations and rules therefore as required in the current manual of survey instructions of the United States Department of the Interior, Bureau of Land Management or by decree of a Court of Law and/or that the corner points mentioned in lines 3, 4, and 5 above were in conformance with the rules of the Michigan Board of Land Surveyors or by decree of a Court of Law; established, re-established, monumented, re-monumented, recovered, found as expressed below:

A	B	C	D	E	F	G	H	I	J	K	L	M
2	6		5		4		3		2		1	
3												
4	7		8		9		10		11		12	
5												
6	18		17		16		15		14		13	
7												
8	19		20		21		22		23		24	
9												
10	30		29		28		27		26		25	
11												
12	31		32		33		34		35		36	
13												

A. Description of original monument and accessories and/or subsequent restoration:

H-6

- 1. CORNER NORTH SET IN ORIGINAL GOVERNMENT SURVEY
- 2. JOHN KAMER P.S. 1986 - SHOWS CORNER ON PLAT OF UPPER SCOTT LAKE ESTATES SUBDIVISION WITH DISTANCE OF 2631.16 FEET SOUTH OF THE NORTH QUARTER POST OF THE SECTION.
- 3. G. MITCHELL P.S. 1987 - FOUND 5/8" REBAR & MEASURED 2631.10 FEET NORTH TO THE NORTH QUARTER POST.

B. Description of corner evidence found and/or method applied in restoring or reestablishing corner:

FOUND 5/8" REBAR FROM ITEMS 2 AND 3 OF ABOVE CORNER HISTORY. FOUND CORNER IS LOCATED 1.94 FEET SOUTH AND 0.11 FEET EAST OF THE INTERSECTION OF THE QUARTER LINES.

SET ALLEGAN COUNTY STANDARD 3/4" BY 36" IRON PIN WITH REMON CAP.


THIS CORNER WAS APPROVED BY THE ALLEGAN COUNTY SURVEYORS PEER GROUP ON OCTOBER 12, 1999

C. Description of monument for corner and accessories established to perpetuate locating the position of the corner:

CENTER OF SECTION 15, TOWN 1 NORTH, RANGE 15 WEST

- A.C. REMON TAG & NAIL IN NORTH SIDE OF POWER POLE AZ. 095° 30.80 FEET
- A.C. REMON TAG & NAIL IN SOUTHWEST SIDE OF TWIN 12" CHERRY AZ. 340° 48.95 FEET
- A.C. REMON TAG & NAIL IN NORTH SIDE OF 24" OAK AZ. 270° 12.54 FEET
- A.C. REMON TAG & NAIL IN SOUTHWEST SIDE OF 12" OAK AZ. 155° 75.17 FEET
- CENTER OF NORTH-SOUTH GRAVEL ROAD AZ. 270° 5 FOOT
- H-6 TO H-5 MEASURED 2631.00 FEET
- H-6 TO H-7 MEASURED 2651.28 FEET
- H-6 TO G-6 MEASURED 2642.97 FEET

APPROVED REMONUMENTATION CORNER  
P.A. 345 OF 1990  
ALLEGAN COUNTY  
DATE APPROVED OCT. 12, 1999  
COUNTY REP. [Signature]

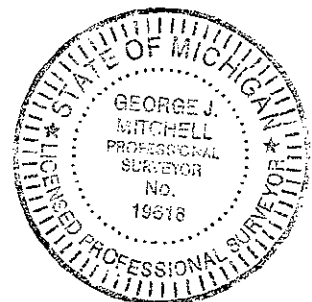

Signed by George J. Mitchell Date 10/28/99

Surveyor's Michigan License No. ....19618.....