

MAR 07 2000

ALLEGAN COUNTY REMONUMENTATION

LAND CORNER RECORDATION CERTIFICATE

SECTION

Filing Requirement of Act 74, Mich. P.A. 1970

For corners in

ALLEGAN COUNTY..... Located in: ..LEE..... Township Corner Code #

- 1. Public Land Survey T.1 N., R.15 W. ....H-9.....
2. Property Controlling S..... T..... R.....
3. Miscellaneous S..... T..... R.....
4. Lot No. ...., Recorded Plat .....
5. Private Claims.....

REGISTER OF DEEDS ALLEGAN COUNTY

00 FEB - 1 11 03 42

LIBRO 007 PAGE 39 FILED

Register of Deeds Stamp & File Number

I, .... George J. Mitchell....., in a field survey on ...September 29, 1999..... do hereby certify that under requirements of P.A. 74, Michigan P.A. of 1970, the corner points mentioned in lines 1 and 2 above were in conformance with regulations and rules therefore as required in the current manual of survey instructions of the United States Department of the Interior, Bureau of Land Management or by decree of a Court of Law and/or that the corner points mentioned in lines 3, 4, and 5 above were in conformance with the rules of the Michigan Board of Land Surveyors or by decree of a Court of Law; established, re-established, monumented, re-monumented, recovered, found as expressed below:

Grid table with columns A-M and rows 2-13. A dot is marked at the intersection of column H and row 9.

A. Description of original monument and accessories and/or subsequent restoration:

H-9

SEE SHEET 2 OF 2 FOR CORNER HISTORY

B. Description of corner evidence found and/or method applied in restoring or reestablishing corner:

FOUND 5/8" REBAR FROM ITEM 4 OF CORNER HISTORY, AND IS ACCEPTED AS A CAREFUL AND FAITHFUL PERPETUATION OF THE POSITION OF THE ORIGINAL CORNER.

SET ALLEGAN COUNTY STANDARD 3/4" BY 36" IRON PIN WITH REMON CAP

THIS CORNER WAS APPROVED BY THE ALLEGAN COUNTY SURVEYORS PEER GROUP ON OCTOBER 12, 1999

C. Description of monument for corner and accessories established to perpetuate locating the position of the corner:


SOUTH QUARTER POST, SECTION 22, TOWN 1 NORTH, RANGE 15 WEST

- A.C. REMON TAG & NAIL IN WEST SIDE OF 48" OAK AZ. 177° 38.00 FEET
A.C. REMON TAG & NAIL IN WEST SIDE OF 12" CHERRY AZ. 180° 10.13 FEET
A.C. REMON TAG & NAIL IN NORTH SIDE OF 36" TW. MAPLE AZ. 240° 31.05 FEET
A.C. REMON TAG & NAIL IN SOUTHWEST SIDE OF 8" CHERRY AZ. 345° 23.85 FEET
A.C. REMON TAG & NAIL IN NORTHWEST SIDE OF 8" ASH AZ. 015° 23.72 FEET
CORNER IS ON EAST EDGE OF OLD TRAIL TO NORTH
H-9 TO H-8 MEASURED 2630.64 FEET
H-9 TO I-9 MEASURED 2621.54 FEET
H-9 TO G-9 MEASURED 2633.63 FEET

APPROVED REMONUMENTATION CORNER P.A. 345 OF 1990 ALLEGAN COUNTY DATE APPROVED OCT. 12, 1999 COUNTY REP. [Signature]

Signed by George J. Mitchell Date 10/28/99

Surveyor's Michigan License No. ....19618.....

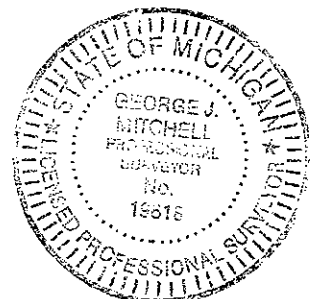

PF

MAR 07 2000

SECTION

GOVERNMENT CORNER HISTORY

SOUTH QUARTER POST OF SECTION 22  
TOWN 1 NORTH, RANGE 15 WEST

H-9

1000007 PAGE 340

1. C. BRITAIN D.S. 1831 EAST ON RANDOM LINE BETW SECT 22 & 27, SET TEMP POST AT 40 CHAINS. INTERSECT E. LINE OF SEC AT 79.86 CHAINS 17 LKS N. OF POST.  
WEST CORRECT BETWEEN SECT 22 & 27 39.93 CHAINS, SET POST  
12 HEMLOCK S57W 48 LKS  
16 HEMLOCK N38E 26 LKS
2. OLD NOTES NO DATE STAKE  
2635' NORTH TO CENTER
3. D. RATEKIN P.S. 1981 PAPER LOCATION IS AT INTERSECTION POINT OF LINE FROM CENTER OF SECTION SOUTH THROUGH EIGHTH POST ON QUARTER LINE TO LINE BETWEEN SE AND SW CORNERS OF SECTION.  
2631.32' NORTH TO CENTER.
4. R. VUGTEREEN P.S. 1998 SET 5/8" REBAR AT LOCATION DESCRIBED ABOVE  
NO WITNESSES  
2630.61' NORTH TO CENTER  
2621.54' EAST TO SE CORNER  
2633.69' WEST TO SW CORNER
5. G. MITCHELL P.S. 1999 FD 5/8" REBAR R. VUGTEREEN CAP  
MEASURED 2630.64' NORTH TO CENTER  
MEASURED 2621.54' EAST TO E1/4 POST  
MEASURED 2633.63' WEST TO W1/4 POST