

**SURVEY
REMONUMENTATION**

APR 29 1998

ALLEGAN COUNTY REMONUMENTATION

SECTION LAND CORNER RECORDATION CERTIFICATE

For corners in

Filing Requirement of Act 74, Mich. P.A. 1970

.....ALLEGAN..... Township **LEE** Located in: Corner Code #

1. Public Land Survey T.1.N R.15 W. H-13.....
T..... R..... S1/4 POST, SEC 34

2. Property Controlling S..... T..... R.....
in Section S..... T..... R.....

3. Miscellaneous S..... T..... R.....
Property in Sec. S..... T..... R.....

4. Lot No. Recorded Plat

5. Private Claims.....

FILED


1/28/1999 2:44:39 PM

JOYCE A. WATTS
REGISTER OF DEEDS
ALLEGAN COUNTY, MICH

Register of Deeds Stamp & File Number

LIBER 006 PAGE 67

I, **George J. Mitchell**, in a filed survey on **10/26 thru 11/07/98** do hereby certify that under requirements of P.A. 74, Michigan P.A. of 1970, the corner points mentioned in lines 1 and 2 above were in conformance with regulations and rules therefore as required in the current manual of survey instructions of the United States Department of the Interior, Bureau of Land Management or by decree of a Court of Law and/or that the corner points mentioned in lines 3, 4, and 5 above were in conformance with the rules of the Michigan Board of Land Surveyors or by decree of a Court of Law, established, re-established, monumented, re-monumented, recovered, found as expressed below:

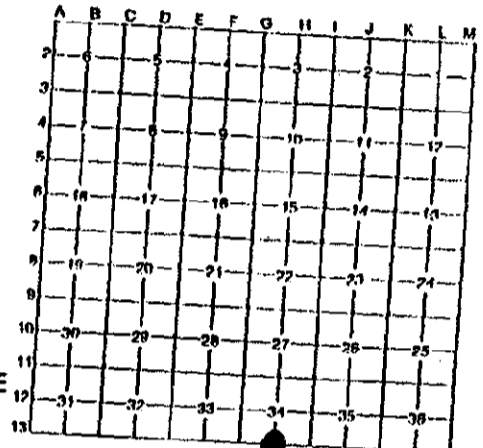

- A. Description of original monument and accessories and/or subsequent restoration:
- W. BROOKFIELD 1827 WEST ON SOUTH SIDE OF SECTION 34, SET POST AT 40 CAHINS PINE 8 N79-1/2E47 LKS CHERRY 6 N72 2/3W 102 LKS 43.60 CH BROOK 25 LKS WIDE
 - G. MITCHELL P.S. 1984 SET 5/8 IRON BAR EQUIDISTANT ON LINE BETWEEN G-13 & I-13 40' MAPLE N5W 15.4' 10' ELM N85E 14.2' 15' MAPLE S10W 33.7' 10' MAPLE S45E 33.9' C.L. ROAD SOUTH 6.0' C.L. STREAM WEST 230'
 - G. MITCHELL P.S. 1990 FOUND 5/8" IRON BAR SAME WITNESSES AS 1984

- B. Description of corner evidence found and/or method applied in restoring or reestablishing corner:
- H-13) FOUND 5/8" IRON BAR FROM CORNER HISTORY AND IS ACCEPTED AS A CAREFUL AND FAITHFUL PERPETUATION OF THE POSITION OF THE ORIGINAL CORNER.

THIS CORNER WAS APPROVED BY THE ALLEGAN COUNTY SURVEYORS PEER GROUP ON NOVEMBER 10, 1998

- C. Description of monument for corner and accessories established to perpetuate locating the position of the corner:
- H-13) SOUTH QUARTER POST OF SECTION 34, TOWN 1 NORTH, RANGE 15 WEST

- REMOVED 5/8" IRON BAR AND SET 3/4" X 36" IRON PIN WITH ALLEGAN CO. REMON CAP.
- A.C. REMON TAG & NAIL IN EAST SIDE OF 44" MAPLE AZ. 355° 15.00 FEET
- A.C. REMON TAG & NAIL IN SE SIDE OF 12" MAPLE AZ. 135° 33.85 FEET
- A.C. REMON TAG & NAIL IN EAST SIDE OF 18" MAPLE AZ. 190° 33.82 FEET
- A.C. REMON TAG & NAIL IN SW SIDE OF 12" MAPLE AZ. 225° 48.75 FEET
- C/L ROAD AZ. 180° 6.0 FEET
- C/L STREAM AZ. 270° 230 FEET

APPROVED REMONUMENTATION CORNER
P.A. 345 OF 1990
ALLEGAN COUNTY
DATE APPROVED Nov. 10, 1998
COUNTY REP. [Signature]

Signed by George J. Mitchell Date Nov. 11, 1998
Surveyor's Michigan License No. 19618

