

MAR 07 2000

ALLEGAN COUNTY REMONUMENTATION

LAND CORNER RECORDATION CERTIFICATE

SECTION

Filing Requirement of Act 74, Mich. P.A. 1970

For corners in

ALLEGAN COUNTY..... Located in: ..LEE..... Township
Corner Code #

- 1. Public Land Survey T.1 N.. R.15 W.I-4.....
T..... R..... E1/4 POST SEC. 10
- 2. Property Controlling S..... T..... R.....
in Section S..... T..... R.....
- 3. Miscellaneous S..... T..... R.....
Property in Sec. S..... T..... R.....
- 4. Lot No., Recorded Plat
- 5. Private Claims.....

REGISTER OF DEEDS
ALLEGAN COUNTY, MI


00 FEB -1 11 9:42

FILED

LIBRARY / PAID 341

Register of Deeds Stamp & File Number

I, **George J. Mitchell**....., in a field survey on ...**October 1, 1999**.....
do hereby certify that under requirements of P.A. 74, Michigan P.A. of 1970, the corner
points mentioned in lines 1 and 2 above were in conformance with regulations and rules
therefore as required in the current manual of survey instructions of the United States
Department of the Interior, Bureau of Land Management or by decree of a Court of Law
and/or that the corner points mentioned in lines 3, 4, and 5 above were in conformance
with the rules of the Michigan Board of Land Surveyors or by decree of a Court of Law;
established, re-established, monumented, re-monumented, recovered, found as expressed
below:

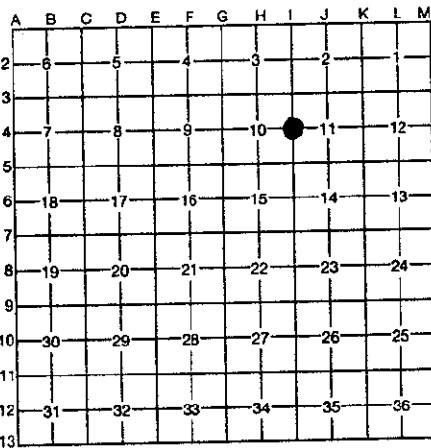

NOTE: Not more than 4 corners, all in the same town & range, may be recorded on this certificate.

A. Description of original monument and accessories and/or subsequent restoration:
I-4

SEE SHEET 2 OF 2 FOR CORNER HISTORY

B. Description of corner evidence found and/or method applied in restoring or reestablishing corner:

FOUND 1-1/2" IRON BAR IN MON BOX FROM ITEMS 3 THROUGH 6 OF CORNER HISTORY, AND IS ACCEPTED AS A CAREFUL AND FAITHFUL PERPETUATION OF THE POSITION OF THE ORIGINAL CORNER.

DROVE 1-1/2" IRON BAR DOWN AND SET ALLEGAN COUNTY 3/4" BY 12" IRON PIN WITH REMON CAP ON TOP OF BAR IN MON BOX

THIS CORNER WAS APPROVED BY THE ALLEGAN COUNTY SURVEYORS PEER GROUP ON OCTOBER 12, 1999

C. Description of monument for corner and accessories established to perpetuate locating the position of the corner:


EAST QUARTER POST OF SECTION 10, TOWN 1 NORTH, RANGE 15 WEST

- A.C. REMON TAG & NAIL IN SOUTHEAST SIDE OF 8" TWIN MAPLE AZ. 210° 85.45 FEET
 - A.C. REMON TAG & NAIL IN SOUTHWEST SIDE OF 10" POPLAR AZ. 310° 82.65 FEET
 - A.C. REMON TAG & NAIL IN NORTHEAST SIDE OF POWER POLE AZ. 135° 53.45 FEET
 - A.C. REMON TAG & NAIL IN SOUTH SIDE OF 14" PINE AZ. 045° 65.40 FEET
 - A.C. REMON TAG & NAIL IN WEST SIDE OF 10" TWIN OAK AZ. 160° 91.80 FEET
- MEASURED 2622.961 FEET WEST TO CENTER OF THE SECTION

APPROVED REMONUMENTATION CORNER
P.A. 345 OF 1990
ALLEGAN COUNTY
DATE APPROVED OCT. 12, 1999
COUNTY REP. [Signature]

Signed by George J. Mitchell Date 10/28/99

Surveyor's Michigan License No.19618.....

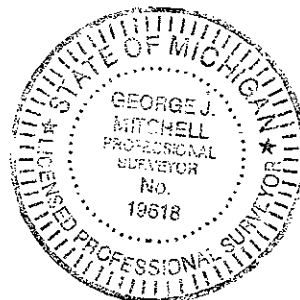

RECORDED
INDEXED

GOVERNMENT CORNER HISTORY

MAR 07 2000

EAST QUARTER POST OF SECTION 10
TOWN 1 NORTH, RANGE 15 WEST

SECTION

1-4

- 1. C. BRITAIN D.S. 1831 NORTH BETW SECT 10 & 11
SET 1/4 SEC POST AT 40.00 CH.
14 PINE S71E 11 LKS
15 PINE S37W 30 LKS
- 2. OLD NOTES NO DATE
STAKE & STONE
24" OAK NNE 37.9'
ST. SIGN NW 47.0'
TELE POLE NW 56.4'
POWER POLE SE 52.8'
- 3. D. MIDDLETON P.S. 1971 L.C.R.C. L. 001, P. 164
FD 1- 1/4" IRON IN MON BOX
POWER POLE S45E 53.51'
POST FOR T.C.B. S60W 62.5'
POST FOR T.C.B. N60W 56.2'
IRON IS 2' NORTH OF RD. CENTER
IRON IS IN CENTER OF N-S ROAD
- 4. D. RAKEKIN P.S. CARD FILE SAME AS ABOVE
- 5. G. MITCHELL P.S. 1980
FD IRON IN MON BOX
TELE POLE SE 53.1'
STREET SIGN NW 44.5'
T.C.B. SW 62.2'
- 6. G. MITCHELL P.S. 1988
FD IRON IN MON BOX
POWER POLE SE 53.1'
T.C.B. NW 56.1'
T.C.B. SW 61.6'
- 7. G. MITCHELL P.S. 1999 FD 1-1/2" IRON IN MON BOX FROM ABOVE WITNESSES

LIBRO 007 PAGE 12