

MAR 07 2000

ALLEGAN COUNTY REMONUMENTATION

SECTION

LAND CORNER RECORDATION CERTIFICATE

Filing Requirement of Act 74, Mich. P.A. 1970

For corners in

ALLEGAN COUNTY..... Located in: ..LEE..... Township
Corner Code #

- 1. Public Land Survey T.1 N.. R.15 W.I-5.....
T..... R..... SE CORNER, SEC. 10
- 2. Property Controlling S..... T..... R.....
in Section S..... T..... R.....
- 3. Miscellaneous S..... T..... R.....
Property in Sec. S..... T..... R.....
- 4. Lot No., Recorded Plat
- 5. Private Claims.....

00 FEB -1 AM 8 42
George J. Mitchell
REGISTER OF DEEDS
ALLEGAN COUNTY

FILED
LH00007 PAGE 13

Register of Deeds Stamp & File Number


I, **George J. Mitchell**....., in a filed survey on ...**December 27, 1999**... do hereby certify that under requirements of P.A. 74, Michigan P.A. of 1970, the corner points mentioned in lines 1 and 2 above were in conformance with regulations and rules therefore as required in the current manual of survey instructions of the United States Department of the Interior, Bureau of Land Management or by decree of a Court of Law and/or that the corner points mentioned in lines 3, 4, and 5 above were in conformance with the rules of the Michigan Board of Land Surveyors or by decree of a Court of Law; established, re-established, monumented, re-monumented, recovered, found as expressed below:

NOTE: Not more than 4 corners, all in the same town & range, may be recorded on this certificate.

A. Description of original monument and accessories and/or subsequent restoration:

I-5

SEE SHEET 2 OF 2 FOR CORNER HISTORY

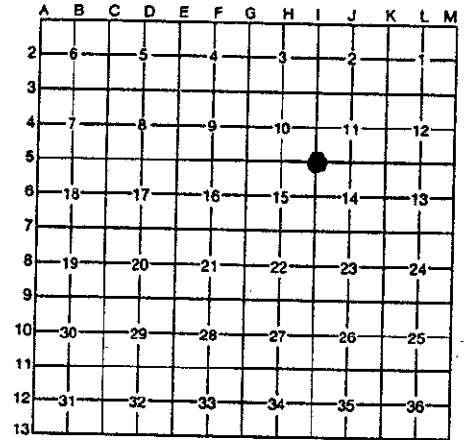

B. Description of corner evidence found and/or method applied in restoring or reestablishing corner:

FOUND 3/4" TAPPED BAR WITH STONE FROM NO. 3, 4, AND 5 OF CORNER HISTORY. MEASUREMENT WEST TO SOUTH QUARTER POST AGREE WITH 1907 MEASUREMNET. REMOVED TAPPED BAR AND SET STANDARD ALLEGAN CO. MONUMENT WITH RED CAP AND IS ACCEPTED AS A CAREFUL AND FAITHFUL PERPETUATION OF THE ORIGINAL CORNER.

THIS CORNER WAS APPROVED BY THE ALLEGAN COUNTY SURVEYORS PEER GROUP ON DECEMBER 28, 1999

C. Description of monument for corner and accessories established to perpetuate locating the position of the corner:

SOUTHEAST CORNER OF SECTION 10, TOWN 1 NORTH, RANGE 15 WEST

ALLEGAN COUNTY STANDARD 3/4" BY 36" IRON PIN WITH REMON CAP

- A.C. REMON TAG & NAIL IN NORTH SIDE OF POWER POLE AZ. 090° 27.80 FEET
- A.C. REMON TAG & NAIL IN WEST SIDE OF 28" OAK AZ. 180° 28.55 FEET
- A.C. REMON TAG & NAIL IN SOUTHEAST SIDE OF 30" OAK AZ. 230° 53.77 FEET
- A.C. REMON TAG & NAIL IN NORTHEAST SIDE OF 26" OAK AZ. 315° 31.60 FEET
- EAST FACE OF FENCE CORNER POST AZ. 270° 5.80 FEET

APPROVED REMONUMENTATION CORNER
P.A. 345 OF 1990
ALLEGAN COUNTY
DATE APPROVED DEC. 28, 1999
COUNTY REP. [Signature]

Signed by George J. Mitchell Date 12/30/99
Surveyor's Michigan License No.19618.....



QUINCY
RECORDS SECTION

MAR 07 2000

SECTION

LIBRO 0 0 7 PAGE 3 1 4

GOVERNMENT CORNER HISTORY

SOUTHEAST CORNER SECTION 10
TOWN 1 NORTH, RANGE 15 WEST

I - 5

1. C. BRITAIN D.S. 1831
NORTH BET. SECTIONS 14 & 15
SET POST AT 80 CHAINS
14 W. OAK N53W 32 LKS.
12 PINE S06E 16 LKS.

2. H. MCDOUGHAL 1907
STAKE & STONE
SHOWS DISTANCE OF 2625.2 FEET WEST TO S1/4 POST
MEASURED 2625.32 FEET (SEPT. 1999)

3. D. RATEKIN P.S. (CARD FILE)
1" IRON & STONE
POWER POLE EAST 27.4'
13" OAK SE 48.6'
14" OAK SOUTH 28.6'
2625.8' WEST TO S1/4 POST

4. D. BONNEMA P.S. 1972
1/2" IRON
20" OAK SW 54.2'
10" OAK NW 31.49'
T. POLE E 27.71'

5. G. MITCHELL P.S. 1995
3/4" IRON & STONE
SAME WITNESSES AS BONNEMA

6. G. MITCHELL P.S. 1999
FOUND 3/4" IRON & STONE