


**ALLEGAN COUNTY REMONUMENTATION
LAND CORNER RECORDATION CERTIFICATE**

Filing Requirement of Act 74, Mich. P.A. 1970

For corners in

ALLEGAN COUNTY..... Located in: LEE Township
Corner Code #

1. Public Land Survey T.1 N. R.15 W. J-13.....
T..... R..... 5/4 Post, SEC 35
2. Property Controlling S..... T..... R.....
in Section S..... T..... R.....
3. Miscellaneous S..... T..... R.....
Property in Sec. S..... T..... R.....
4. Lot No., Recorded Plat
5. Private Claims.....

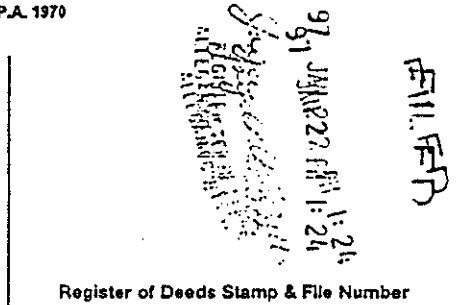

I, George J. Mitchell, in a filed survey on 10/15/95 & 10/21/96 do hereby certify that under requirements of P.A. 74, Michigan P.A. of 1970, the corner points mentioned in lines 1 and 2 above were in conformance with regulations and rules therefore as required in the current manual of survey instructions of the United States Department of the Interior, Bureau of Land Management or by decree of a Court of Law and/or that the corner points mentioned in lines 3, 4, and 5 above were in conformance with the rules of the Michigan Board of Land Surveyors or by decree of a Court of Law, established, re-established, monumented, re-monumented, recovered, found as expressed below:

A	B	C	D	E	F	G	H	I	J	K	L	M
2	6	5	4	3	2	1	1	1	1	1	1	1
3												
4	7	8	9	10	11	12						
5												
6	16	17	18	19	20	21						
7												
8	19	20	21	22	23	24						
9												
10	30	29	28	27	26	25						
11												
12	31	32	33	34	35	36						
13												

NOTE: Not more than 4 corners, all in the same town & range, may be recorded on this certificate.

A. Description of original monument and accessories and/or subsequent restoration:

J-13

SEE SHEET 2 OF 2 FOR CORNER HISTORY

APPROVED REMONUMENTATION CORNER
P.A. 345 OF 1990
ALLEGAN COUNTY
DATE APPROVED 11-12-96
COUNTY REP. George J. Mitchell



B. Description of corner evidence found and/or method applied in restoring or reestablishing corner:
J-13

FOUND 1-1/4" PIPE FROM CORNER HISTORY AND ACCEPTED ITS LOCATION AS A CAREFUL AND FAITHFUL PERPETUATION OF THE POSITION OF THE ORIGINAL CORNER.

THIS CORNER WAS APPROVED BY THE ALLEGAN COUNTY SURVEYORS PEER GROUP ON NOVEMBER 12, 1996

C. Description of monument for corner and accessories established to perpetuate locating the position of the corner:
J-13


REPLACED 1-1/4" PIPE WITH ALLEGAN COUNTY STANDARD 3/4" BY 36" IRON PIN WITH REMON CAP.

A.C. REMON TAG & NAIL IN SOUTHEAST SIDE OF 12" OAK	AZ.	42°	36.90 FEET
A.C. REMON TAG & NAIL IN NORTHEAST SIDE OF 48" OAK	AZ.	105°	45.84 FEET
A.C. REMON TAG & NAIL IN EAST SIDE 20" OAK	AZ.	170°	46.07 FEET
A.C. REMON TAG & NAIL IN NORTH SIDE OF 48" OAK	AZ.	260°	91.25 FEET
STOP SIGN POST AT GOUND	AZ.	290°	53.90 FEET

Signed by George J. Mitchell Date November 12, 1996
Surveyor's Michigan License No.19618.....

SHEET 1 OF 2

LIBR 0005 PAGE 422

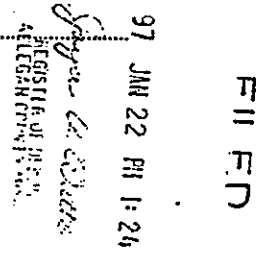

GOVERNMENT CORNER HISTORY
 SOUTH QUARTER POST OF SECTION 35
 TOWN 1 NORTH, RANGE 15 WEST

J-13

H. BRITAIN 1831	SE POST WEST 40 CHAINS BEECH 10 N53E 43 LKS HEMLOCK 6 N25W 16 LKS
RATEKIN WITNESS CARD	1-1/4" PIPE 30" W. OAK SE 44.8' 15" PINE SSE 46.2' 28" PINE SW 66.9' SHOWS 2634.66' EAST TO SE COR. SHOWS 2619.01' NORTH TO CENTER
MITCHELL 1989	FOUND 1-1/4" PIPE 36" OAK SE 44.55' T.C. BOX SW 84.20' 12" PINE NW 29.70' 12" PINE NE 36.4'
MITCHELL 10/1996	FOUND 1-1/4" PIPE 12" OAK NE 36.90' 48" OAK SSE 45.84' 40" OAK SOUTH 46.07' 48" OAK WSW 91.25' STOP SIGN WNW 53.90' MEAS 2634.00' EAST TO SE COR. MEAS. 2619.00 NORTH TO CENTER

REMARKS

