

APR 29 1999

SECTION

ALLEGAN COUNTY REMONUMENTATION
LAND CORNER RECORDATION CERTIFICATE
Filing Requirement of Act 74, Mich. P.A. 1970

LIBER 006 PAGE 470

For corners in
Allegan
 (County)

Located In: _____ Corner Code # _____

1. Public Land Survey T1N R15W K-1
 T R _____
 T R _____
 T R _____
 Lee Twp.

2. Property Controlling S T R _____
 in Section S T R _____

3. Miscellaneous S T R _____
 Property in Sec. S T R _____

4. Lot No. _____, Recorded Plat _____

5. Private Claims _____

FILED
 1/28/1999 2:44:39 PM
 JOYCE A. WATTS
 REGISTER OF DEEDS
 ALLEGAN COUNTY, MICH.
 Register of Deeds Stamp & File Number

I, Donald R. Pitts, Jr., in a field survey on October 1, 1998, do hereby certify that under requirements of P.A. 74, Michigan P.A. of 1970, the corner points mentioned in lines 1 and 2 above were in conformance with regulations and rules therefore as required in the current manual of survey instructions of the United States Department of the Interior, Bureau of Land Management or by a decree of a Court of Law and/or that the corner points mentioned in lines 3, 4 and 5 above were in conformance with the rules of the Michigan Board of Land Surveyors or by a Decree of a Court of Law; established, re-established, monumented, re-monumented, recovered, found as expressed below:

NOTE: Not more than 4 corners, all in the same town and range, may be recorded on this certificate.

A. Description of original monument and accessories and/or subsequent restoration:

1831 - Calvin Britain 1983 J. H. Dillingham - L.C.R.C., L3, P364
 Intersected town line 43 lks (28.38') E of post - Set post Set iron rod with cap on straight line and
 W Oak 4 S 30 W 37 double distance from NE corner and N 1/4 post
 W Oak 9 S 35 E 48 as shown on record in Allegan County
 36" Oak S 5 W 31.5'
 18" Twin Oak S 50 E 72.2'
 16" Oak N 35 E 32.3'
 12" Pine N 20 W 40.1'

1906 County Surveyors Records Stone
 Jog 28.38'

1988
 F. J. Vugteveen - L.C.R.C. L4, P46
 Part "A": 1906 notes from Allegan County Surveyors Office call for Stone 28.38' East of SE corner, Section 35, Town 2 North, Range 15 West, and 3008' (Government 3005.64') from the East 1/4 corner, Section 2, Town 1 North, Range 15 West.
 CONTINUED ON REVERSE SIDE

B. Description of corner evidence found and/or method applied in restoring or reestablishing corner:

Found capped iron, L.C.R.C., Liber 4, Page 46, (4.5' South and 16' East of capped iron, L.C.R.C., Liber 003, Page 364).
 Pulled iron, Liber 4, Page 46 found pointed stone under 0.05' South
 SE corner Section 35, Town 2 North, Range 15 West (DNR Monument) N 90 W 26.25'
 Square spike in NW side 40" Red Oak S 50 W 37.40' Square spike in NE side 14" Red Pine N 52 W 72.70'
 Square spike in SE side 10" White Oak N 42 E 54.73' Square spike in SW side 20" Twin Oak S 54 E 55.54'
 Centerline 112th Avenue N 7'
 Centerline 60th St. E 5'
 Capped iron (L.C.R.C., Liber 3, Page 364) N 75 W 17.16'
 Pulled capped iron (L.C.R.C., Liber 4, Page 46) and set Standard Allegan County Remonumentation 3/4"x24" iron With red cap #23520.

Approved by the Allegan County Remonumentation Peer Group November 10, 1998 and is accepted as a careful and Faithful perpetuation of the position of the original corner.
 APPROVED REMONUMENTATION CORNER
 P.A. 345 OF 1990
 ALLEGAN COUNTY


Pulled capped iron L.C.R.C., Liber 3, Page 364
 DATE APPROVED Nov. 10, 1998
 COUNTY REP. [Signature]

C. Description of monument for corner and accessories established to perpetuate locating the position of the corner:

Standard Allegan County Remonumentation 3/4"x24" iron with red cap #23520
 K-13, Town 2 North, Range 15 West Standard Allegan County Remonumentation 3/4"x24" iron with red cap #23520 West 26.25'
 Nail with Allegan County Remonumentation tag SE side 10" Oak N 36 E 54.74'
 Nail with Allegan County Remonumentation tag NE side 8" Oak S 44 E 72.62'
 Nail with Allegan County Remonumentation tag SE side 12" Pine S 61 W 73.80'
 Nail with Allegan County Remonumentation tag W side 12" Oak N 23 W 63.52'

Signed by Donald R. Pitts, Jr.
 Surveyor's Michigan License No. 25867

Date December 29, 1998

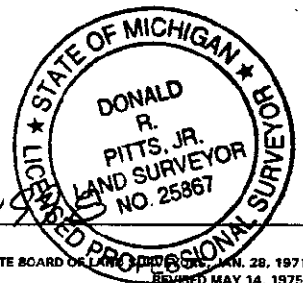

SURVEY
REMONUMENTATION

APR 29 1999

SECTION

LIBER 006 PAGE 71

A. Description of original monument and accessories and/or subsequent restoration:

Part "B": Found pointed stone with pieces of iron, 26.35' E of SE corner Sec. 35, T2N, R15W, (2"x6" iron) and 3006.14' N of E 1/4 corner of Sec. 1, T1N, R15W. Set capped iron above. This is 4.5' S and 16' E of capped iron previously recorded as NE corner of Section 2, T1N, R15W, in Liber 003, Page 364.

Part "C": Capped iron
SE corner Sec. 35, T2N, R15W, (2"x6" iron)
N 90° W 26.35'

Square spike in NW side 40" Red Oak S 50 W 37.35'
Square spike in NE side 14" Red Pine N 52 W 72.72'
Square spike in SE side 10" White Oak N 42 E 54.77'
Square spike in SW side 20" Twin Oak S 54 E 55.49'
Centerline 112th Avenue N 7'
Centerline 60th Street E 5'

1991 Gary Bilow - L.C.R.C., Liber 4, Page 118
Found 1/2" capped iron bar (in part B note Vugteveen)
S 55 W 37.38' square nail in NW face 45" Oak
N 55 W 72.84' square nail in NE face 14" Red Pine
N 35 E 54.85' square nail in E face 10" Oak
S 65 E 55.49' square nail in SW face of Southerly arm of Twin 27" Oak
W 26.32' concrete monument with MDNR cap at SW cor. Sec. 36, T2N, R15W