

**ALLEGAN COUNTY REMONUMENTATION  
LAND CORNER RECORDATION CERTIFICATE**

Filing Requirement of Act 74, Mich. P.A. 1970


For corners in

ALLEGAN COUNTY..... Located in: LEE Township  
Corner Code #

1. Public Land Survey T. 1 N. R. 15 W. K-13
2. Property Controlling S..... T..... R..... SE COR., SEC. 35  
in Section S..... T..... R.....
3. Miscellaneous S..... T..... R.....  
Property in Sec. S..... T..... R.....
4. Lot No. .... Recorded Plat .....
5. Private Claims.....

97 JUN 22 PM 1:24  
 FILED  
 ALLEGAN COUNTY  
 REGISTERED  
 SURVEYORS

I, DONALD R. PITTS, JR., in a filed survey on 10/15/95 & 12/03/96 do hereby certify that under requirements of P.A. 74, Michigan P.A. of 1970, the corner points mentioned in lines 1 and 2 above were in conformance with regulations and rules therefore as required in the current manual of survey instructions of the United States Department of the Interior, Bureau of Land Management or by decree of a Court of Law and/or that the corner points mentioned in lines 3, 4, and 5 above were in conformance with the rules of the Michigan Board of Land Surveyors or by decree of a Court of Law, established, re-established, monumented, re-monumented, recovered, found as expressed below:

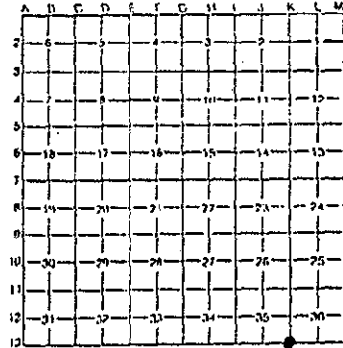

NOTE: Not more than 4 corners, all in the same town & range, may be recorded on this certificate.

A. Description of original monument and accessories and/or subsequent restoration:

K-13

SEE SHEET 2 OF 2

APPROVED REMONUMENTATION CORNER  
 P.A. 345 OF 1990  
 ALLEGAN COUNTY  
 DATE APPROVED 11-30-96  
 COUNTY REP. Donald R. Pitts, Jr.

B. Description of corner evidence found and/or method applied in restoring or reestablishing corner:

K-13

FOUND 1" PIPE - 48" LONG FROM CORNER HISTORY AND ACCEPTED ITS LOCATION AS A CAREFUL AND FAITHFUL PERPETUATION OF THE POSITION OF THE ORIGINAL CORNER

THIS CORNER WAS APPROVED BY THE ALLEGAN COUNTY SURVEYORS PEER GROUP ON NOVEMBER 26, 1996

C. Description of monument for corner and accessories established to perpetuate locating the position of the corner:

K-13


SET ALLEGAN COUNTY STANDARD 3/4" BY 36" IRON PIN WITH REMON CAP.

A.C. REMON TAG & NAIL IN NORTH SIDE OF 10" ASH	AZ.	105°	9.60 FEET
A.C. REMON TAG & NAIL IN SOUTH SIDE OF 12" CHERRY	AZ.	005°	8.52 FEET
A.C. REMON TAG & NAIL IN EAST SIDE OF 18" CHERRY	AZ.	270°	17.50 FEET
A.C. REMON TAG & NAIL IN WEST SIDE OF 6" ASH	AZ.	195°	27.52 FEET

Signed by Donald R. Pitts, Jr. Date 10 December 1996

Surveyor's Michigan License No. 25867

SHEET 1 OF 2

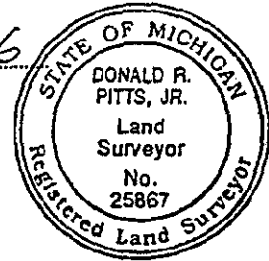

GOVERNMENT CORNER HISTORY  
SOUTHEAST CORNER OF SECTION 35  
TOWN 1 NORTH, RANGE 15 WEST

K-13

BRITAIN D.S. 1831	WEST ON SOUTH SIDE OF SEC 36 40 CHAINS SET POST 80.00 CHAINS SET POST FOR SEC'S 35 & 36 MAPLE 28            N51E 10 LKS PINE 30             WEST 10 LKS
RATEKIN CARD FILE	FD OLD IRON 1" 9" ASH                ESE 9.05' CK 1996 7" W. CHERRY        W 4.48' GONE 1996 6" W. CHERRY        WNW 8.6' GONE 1996 12" W. CHERRY       NNE 7.93' CK 1996 DIST NORTH TO E1/4 POST 2620.54 - MEA 2621.16 (96) DIST WEST TO S1/4 POST 2634.66 - MEA 2634.00 (96)
MITCHELL 1996	FD 1" PIPE 12" ASH                S80E 9.55' 14" W. CHERRY        N20E 8.42'