

MAR 07 2000

ALLEGAN COUNTY REMONUMENTATION

LAND CORNER RECORDATION CERTIFICATE 00 FEB -1 AM 8:36

SECTION

Filing Requirement of Act 74, Mich. P.A. 1970

For corners in


ALLEGAN COUNTY... Located in: ..CASCO... Township Corner Code #

- 1. Public Land Survey T.1 N.. R.16 W.E-10..... T..... R..... E1/4 POST, SECTION 29
2. Property Controlling S..... T..... R..... in Section S..... T..... R.....
3. Miscellaneous S..... T..... R..... Property in Sec. S..... T..... R.....
4. Lot No., Recorded Plat
5. Private Claims.....

Joyce A. ... REGISTER OF DEEDS ALLEGAN COUNTY

Register of Deeds Stamp & File Number

I, George J. Mitchell P.S....., in a field survey on ...May 25, 1999..... do hereby certify that under requirements of P.A. 74, Michigan P.A. of 1970, the corner points mentioned in lines 1 and 2 above were in conformance with regulations and rules therefore as required in the current manual of survey instructions of the United States Department of the Interior, Bureau of Land Management or by decree of a Court of Law and/or that the corner points mentioned in lines 3, 4, and 5 above were in conformance with the rules of the Michigan Board of Land Surveyors or by decree of a Court of Law; established, re-established, monumented, re-monumented, recovered, found as expressed below:

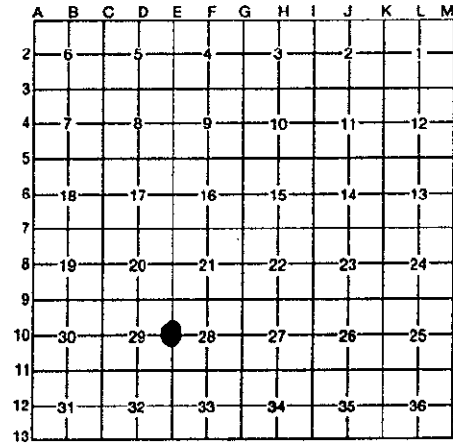

A. Description of original monument and accessories and/or subsequent restoration:

- 1. C. BRITAIN D.S. 1831 - SET POST - SUGAR 10- S49E, 6 LKS & SUGAR 12- N68W, 25 LKS
2. D. RATEKIN P.S. 1971 - L.C.R.C. L. 1, P. 20 - FD 2: PIPE - STREET SIGN- SE, 39.7' & 18' MAPLE- SW, 40.0' & 18' MAPLE- NE, 44.2' AND 34' MAPLE- NW, 51.2'
3. P. VANKOOTEN 1973 - L.C.R.C. L. 2, P. 115 - FD 2' IRON - 24' MAPLE- SSE, 56.42' & 14' SPRUCE- WNW, 70.58' AND 18' MAPLE- NW, 53.68' NOTE: SAME WITNESSES AS E-9
4. G. MITCHELL P.S. 1978 - FD 5/8" REBAR - 6" ASH- S20W, 120.12' & 6" CHERRY- N60W, 66.73' AND T.C.B. - S50W, 51.85'
5. G. MITCHELL P.S. 1988, 1990, 1995, AND 1998 - FD 5/8" REBAR FROM ABOVE WITNESSES

B. Description of corner evidence found and/or method applied in restoring or reestablishing corner:

FOUND 5/8" REBAR FROM ITEMS 2 AND 4 OF ABOVE CORNER HISTORY, AND IS ACCEPTED AS A CAREFUL AND FAITHFUL PERPETUATION OF THE POSITION OF THE ORIGINAL CORNER.

SET ALLEGAN COUNTY STANDARD 3/4" BY 24" IRON PIN WITH REMON CAP IN MONUMENT BOX.

THIS CORNER WAS APPROVED BY THE ALLEGAN COUNTY SURVEYORS PEER GROUP ON JUNE 8, 1999

C. Description of monument for corner and accessories established to perpetuate locating the position of the corner:

EAST QUARTER POST OF SECTION 29, TOWN 1 NORTH, RANGE 16 WEST.

- A.C. REMON TAG & NAIL IN NORTHEAST SIDE OF TWIN 12" ASH AZ. 135° 87.60 FEET
A.C. REMON TAG & NAIL IN SOUTHEAST SIDE OF POWER POLE AZ. 215° 163.77 FEET
A.C. REMON TAG & NAIL IN NORTHEAST SIDE OF 8" ASH AZ. 315° 80.12 FEET
SOUTHWEST CORNER OF CONCRETE VAULT OF GENERAL TELEPHONE AZ. 040° 72.58 FEET

APPROVED REMONUMENTATION CORNER P.A. 345 OF 1990 ALLEGAN COUNTY

DATE APPROVED JUNE 8, 1999 COUNTY REP. [Signature]

Signed by George J. Mitchell Date 10/28/99 Surveyor's Michigan License No. 19618

