

RF

PROPERTY &

FILED

MAR 07 2000

ALLEGAN COUNTY REMONUMENTATION

LAND CORNER RECORDATION CERTIFICATE FEB -1 AM 8:36

SECTION

Filing Requirement of Act 74, Mich. P.A. 1970

For corners in


- ALLEGAN COUNTY..... Located in: ..CASCO..... Township
Corner Code #
- Public Land Survey T.1 N. R.16 W.E-11.....
T..... R..... NE CORNER, SECTION 32
 - Property Controlling S..... T..... R.....
in Section S..... T..... R.....
 - Miscellaneous S..... T..... R.....
Property in Sec. S..... T..... R.....
 - Lot No., Recorded Plat
 - Private Claims.....

Joyce A. ...

REGISTER OF DEEDS
ALLEGAN COUNTY, MICH.

Register of Deeds Stamp & File Number

I, **George J. Mitchell P.S.**....., in a field survey on ...**May 25, 1999**.....
do hereby certify that under requirements of P.A. 74, Michigan P.A. of 1970, the corner
points mentioned in lines 1 and 2 above were in conformance with regulations and rules
therefore as required in the current manual of survey instructions of the United States
Department of the Interior, Bureau of Land Management or by decree of a Court of Law
and/or that the corner points mentioned in lines 3, 4, and 5 above were in conformance
with the rules of the Michigan Board of Land Surveyors or by decree of a Court of Law;
established, re-established, monumented, re-monumented, recovered, found as expressed
below:

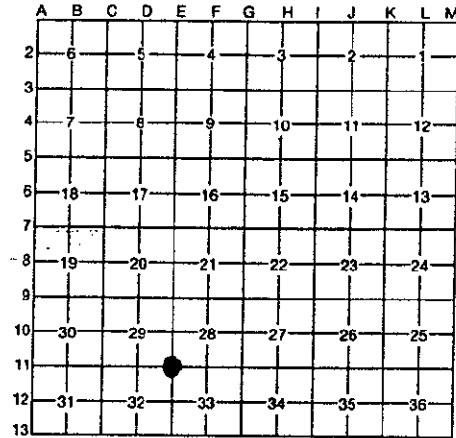

A. Description of original monument and accessories and/or subsequent restoration:

- C. BRITAIN D.S. 1831 - SET POST - HEMLOCK 28- N89E, 15 LKS AND HEMLOCK 18- S18W, 27 LKS
- R. GARDNER 1895 - SET STAKE & STONE
- D. RATEKIN P.S. 1971 - L.C.R.C. L. 1, P. 22 - USED ROAD GRADER TO SEARCH AREA, FOUND NOTHING 0 SET CORNER BY SINGLE PROPRATION - SET 1" IRON - 18" WILD CHERRY- S80W, 103.4' & S. END C.M.P.- S45E, 9.5' & N. END C.M.P.- N30E, 20.0' & POWER POLE- S80W, 84.5'- SET CORNER BY 2634.29' FROM CORNER TO NORTH.
- G. MITCHELL P.S. 1988 - FD 1" IRON - T.C.B. - N70W, 30.45' & T.C.B. - N75E, 32.60' & 8" COTTONWOOD - N80E, 34.78' & IRON - WEST, 33.0' & PLAT MONUMENT - EAST 33.0' - MEAS. 2611.8' NORTH TO 1/4 POST & MEAS. 2656.8' SOUTH TO 1/4 POST.

B. Description of corner evidence found and/or method applied in restoring or reestablishing corner:

FOUND 1" BOLT FROM ITEM 4 OF ABOVE CORNER HISTORY, AND IS ACCEPTED AS A CAREFUL AND FAITHFUL PERPETUATION OF THE POSITION OF THE ORIGINAL CORNER.

SET ALLEGAN COUNTY STANDARD 3/4" BY 36" IRON PIN WITH REMON CAP

THIS CORNER WAS APPROVED BY THE ALLEGAN COUNTY SURVEYORS PEER GROUP ON JUNE 8, 1999

C. Description of monument for corner and accessories established to perpetuate locating the position of the corner:

NORTHEAST CORNER OF SECTION 32, TOWN 1 NORTH, RANGE 16 WEST.


A.C. REMON TAG & NAIL IN NORTHWEST SIDE OF POWER POLE	AZ.	255°	85.20 FEET
A.C. REMON TAG & PK NAIL IN SOUTH END OF 15" C.M.PIPE	AZ.	020°	84.35 FEET
A.C. REMON TAG & PK NAIL IN NORTH END OF 15" C. M. PIPE	AZ.	095°	26.30 FEET
A.C. REMON TAG & PK NAIL IN SOUTH END OF 15" C. M. PIPE	AZ.	340°	116.55 FEET

APPROVED REMONUMENTATION CORNER
P.A. 345 OF 1990
ALLEGAN COUNTY
DATE APPROVED JUNE 8, 1999.
COUNTY REP. *[Signature]*

Signed by *George J. Mitchell*

Date 10/28/99

Surveyor's Michigan License No.19618.....

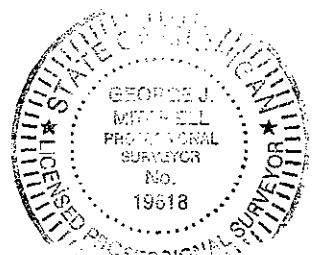

110107 196160