

LAND CORNER RECORDATION CERTIFICATE
Filing Requirement of Act 74, Mich. P.A. 1970

For corners in

Allegan County Located in: Hopkins Corner Code #
(County) Twp., Martin Twp., Watson Twp., & Wayland Twp.

1. Public Land Survey T2N R11W * A-1 MARTIN
T R NW COR. Sec. 6
T3N R11W A-13 WAYLAND
T R SW COR. Sec. 31

2. Property Controlling S T3N R12W M-13 HOPKINS
in Section S T R SE COR. Sec. 36

3. Miscellaneous S T2N R12W M-1 WATSON
Property in Sec. S T R NE COR. Sec. 1


97 JAN 22 PM 1:25
REGISTERED
ALLEGAN COUNTY

Register of Deeds Stamp & File Number

4. Lot No. _____, Recorded Plat _____
5. Private Claims _____

I, Robert Jonker, in a field survey on July 9, 1996, do hereby state that under requirements of P.A. 74, Michigan P.A. of 1970, the corner points mentioned in lines 1 and 2 above were in conformance with regulations and rules therefore as required in the current manual of survey instructions of the United States Department of the Interior, Bureau of Land Management or by a decree of a Court of Law and for that the corner points mentioned in lines 3, 4 and 5 above were in conformance with the rules of the Michigan Board of Land Surveyors or by a Decree of a Court of Law, established, re-established, monumented, recovered, found as expressed below.

NOTE: Not more than 2 corners, all in the same town and range, may be recorded on this certificate.

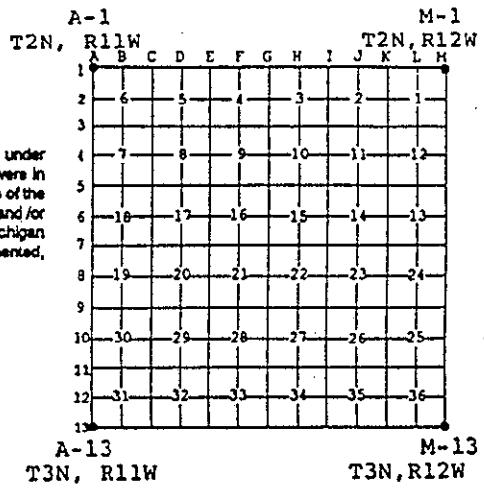

A. Description of original monument and accessories and/or subsequent restoration:
85.85 ch., set post, T2 & 3N, R11 & 12W
Birch 18 N 81 W 4
Do 7 S 77 E 15

Old county surveyor notes, no date, call for stone & brick
Blass wit., no date, 3/4" iron pipe
39" Elm N 37° E 29.77'
18" W.Ch. S 10° E 23.86'
M.B.T. pole S 68° W 49.91'

APPROVED REMONUMENTATION CORNER
P.A. 343 OF 1990
ALLEGAN COUNTY
DATE APPROVED 7-9-96
COUNTY REP. Robert J. Jonker

(OVER)

B. Description of corner evidence found and/or method applied in restoring or reestablishing corner.
Found 3/4" boat spike in mon. box on bridge on West side of US-131 on C/L
E-W pavement as per wit. listed in "A" above per 1974 & 1977 wit.
Replaced with 3/4" x 24" standard Allegan County capped monument.
B-13, T3N, R11W, East 3040.68'
B-1, T2N, R11W, East 3182.20'


Accepted as a careful & faithful perpetuation of the position of the original corner.
Approved by the Allegan County Remonumentation Peer Group on July 9, 1996.

C. Description of monument for corner and accessories established to perpetuate locating the position of the corner.

Allegan County Monument

Nail & tag in top of wooden guardrail post S 56° W 31.52'
Nail & tag in top of wooden guardrail post N 49° W 30.22'
SW corner of SW conc. abutment S 43° E 26.61'
NW corner of NW conc. abutment N 55° E 29.47'
W. edge of bridge East 33.71'

Nail & tags are Allegan Co. Remon. tags.

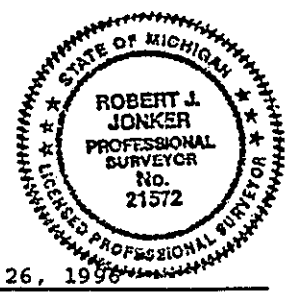

Signed by Robert J. Jonker
Robert J. Jonker, P.S.
Surveyor's Michigan License No. 21572

Date November 26, 1996

A-1 MARTIN TWP.

Part "A" cont'd

Ratekin, 1974 & 1977

3/4" boat spike in box

In C/L road 33.8' West of W. end bridge

SW corner of SW abutment S 50° E 26.6'

NW corner of NW abutment N 50° E 29.51'