

APR 29 1999

SECTION

Allegan County Remonumentation

LAND CORNER RECORDATION CERTIFICATE  
Filing Requirement of Act 74, Mich. P.A. 1970

For corners in

Allegan (County)	Located In:	Corner Code #
1. Public Land Survey	T 2N R 11W	G-1 (NW 3) Martin Twp.
	T R	
	T R	
	T R	
	T R	
2. Property Controlling in Section	S T R	
	S T R	
3. Miscellaneous Property in Sec.	S T R	
	S T R	

FILED

1/28/1999 2:44:39 PM

JOYCE A. WATTS  
REGISTER OF DEEDS  
ALLEGAN COUNTY, MICH

Register of Deeds Stamp & File Number

4. Lot No. \_\_\_\_\_, Recorded Plat \_\_\_\_\_  
5. Private Claims \_\_\_\_\_

Steven Koerber Oct. 6 98  
I, \_\_\_\_\_, in a field survey on \_\_\_\_\_, 19\_\_\_\_ do hereby state that under requirements of P.A. 74, Michigan P.A. of 1970, the corner points mentioned in lines 1 and 2 above were in conformance with regulations and rules therefore as required in the current manual of survey instructions of the United States Department of the Interior, Bureau of Land Management or by a decree of a Court of Law and/or that the corner points mentioned in lines 3, 4 and 5 above were in conformance with the rules of the Michigan Board of Land Surveyors or by a Decree of a Court of Law; established, re-established, monumented, recovered, found as expressed below:

NOTE: Not more than 2 corners, all in the same town and range, may be recorded on this certificate.

	A	B	C	D	E	F	G	H	I	J	K	L	M
1													
2	6		5		4		3		2		1		
3													
4	7		8		9		10		11		12		
5													
6	18		17		16		15		14		13		
7													
8	19		20		21		22		23		24		
9													
10	30		29		28		27		26		25		
11													
12	31		32		33		34		35		36		
13													

A. Description of original monument and accessories and/or subsequent restoration:

G-1	GLO-John Mullet Jan. 1826	Co. Rd. Comm. 1928
	Sugar 12 S69W 23	Peck
	Do. 16 S51E 22	18" Elm North 26.7'
	112 links(73.92') East of post (SE 33, Wayland Twp.)	24" Elm SE 68.1'
		12" Maple SW 36.7'

(Additional info. on back)

B. Description of corner evidence found and/or method applied in restoring or reestablishing corner:

G-1 Found 1" Iron rod in Mon. box  
Nail in P. Pole S45°W 59.84'  
Nail in P. Pole N30°E 40.94'


This corner is accepted as a careful and faithful perpetuation of the position of the original corner.  
Peer Group approval October 13, 1998.

Dist to F-1 = 2664.97'  
Dist to H-1 = 2637.59'

APPROVED REMONUMENTATION CORNER  
P.A. 345 OF 1990  
ALLEGAN COUNTY  
DATE APPROVED OCT. 13, 1998  
COUNTY REP. [Signature]

C. Description of monument for corner and accessories established to perpetuate locating the position of the corner:

G-1 Set Standard Allegan Co. Mon. ( 3/4" x 24" Iron Rod with Remon.cap)  
Set nail & Allegan Co. Remon. tag in W. side P.Pole S50°W 59.97'  
Set nail & Allegan Co. Remon. tag in W. side P.Pole S15°E 66.24'  
Set nail & Allegan Co. Remon. tag in S. side 12" twin Maple S55°E 67.68'  
Set nail & Allegan Co. Remon. tag in SE side P. Pole N50°E 40.82'  
G-13 SW corner Sec. 34-3-11 Wayland Twp. West 73.92'  
On C/1 124<sup>th</sup> Avenue

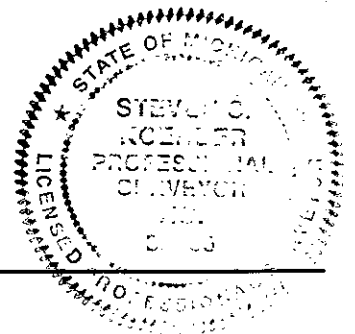

Signed by [Signature]  
Surveyor's Michigan License No. 39085

Date 12-15-1998

LIBR0006 PAGE 93

APR 29 1980

SECTION  
G-1 MARTIN TWP.

Page 2 of 2

2. L.C.R.C. Liber 2, Page 127 October, 1973  
Donald Ratekin  
Found 2" Pipe, raised with 1" pipe  
1" Iron  
Nail in P. Pole S45°W 59.84'  
NW corner headwall S20°E 50.46'  
Nail in P. Pole N30°E 40.94'
  
3. L.C.R.C. Liber 3, Page 324 Feb., 1982  
Paul Van Kooten  
Found 1" solid rod at centerline intersection of 6<sup>th</sup> Street and 124<sup>th</sup> Avenue  
PK nail in NW side P. Pole NE 40.90'  
PK nail in SE side P. pole SW 59.82'  
PK nail in E side P. Pole S-SE 64.70'
  
4. Act 132 survey Liber 1053, Page 71 Jan. 1982  
Paul Van Kooten  
Same wits as No. 3 above

LIBERO 006 PAGE 94