

**SURVEY  
REMONUMENTATION**

APR 29 1999

Allegan County Remonumentation

**SECTION**

**LAND CORNER RECORDATION CERTIFICATE  
Filing Requirement of Act 74, Mich. P.A. 1970**

For corners in

Allegan

(County)

Located In:

Corner Code #

1. Public Land Survey

T 2N R 11W H-1 (N1/4 3) Martin Twp.

2. Property Controlling  
in Section

S T R

3. Miscellaneous  
Property in Sec.

S T R

4. Lot No. \_\_\_\_\_, Recorded Plat \_\_\_\_\_

5. Private Claims \_\_\_\_\_

Steven Koerber

Oct. 6 98

I, \_\_\_\_\_, in a field survey on \_\_\_\_\_, 19\_\_\_\_ do hereby state that under requirements of P.A. 74, Michigan P.A. of 1970, the corner points mentioned in lines 1 and 2 above were in conformance with regulations and rules therefore as required in the current manual of survey instructions of the United States Department of the Interior, Bureau of Land Management or by a decree of a Court of Law and/or that the corner points mentioned in lines 3, 4 and 5 above were in conformance with the rules of the Michigan Board of Land Surveyors or by a Decree of a Court of Law; established, re-established, monumented, recovered, found as expressed below:

NOTE: Not more than 2 corners, all in the same town and range, may be recorded on this certificate.

A. Description of original monument and accessories and/or subsequent restoration:

H-1 Corner not set by GLO April 1869  
E. Strong  
Dist to I-1= 40.20 ch  
Dist to G-1= 39.48 ch

B. Description of corner evidence found and/or method applied in restoring or reestablishing corner:

H-1 Found nothing at corner position  
Set corner position half way between NE corner Section 4 Martin Twp. and the NW corner of Section 4 martin Twp. on the Township line as defined by the South 1/4 corner Section 34, Wayland Twp. and the SE corner Section 34 Wayland Twp.  
This position not established by original government surveyors. This monument is accepted as the best available evidence of the position of the corner.  
Peer Group approval November 10, 1998.

Dist to G-1 = 2637.59'  
Dist to I-1 = 2637.59'

C. Description of monument for corner and accessories established to perpetuate locating the position of the corner:

H-1 Set Standard Allegan Co. Mon. ( 3/4" x 24" Iron Rod with Remon.cap)  
Set nail & Allegan Co. Remon. tag in W. side 48" Maple North 33.24'  
SE edge RR rail on end S10°W 32.58'  
Set nail & Allegan Co. Remon. tag in SE side 42" Maple S60°W 52.29'  
Set nail & Allegan Co. Remon. tag in SW side 44" Maple S65°E 83.66'  
H-13 S 1/4 corner Sec. 34-3-11 Wayland Twp. West 76.13'  
C/L 124<sup>th</sup> Avenue South 4'

FILED

1/28/1999 2:44:39 PM

JOYCE A. WATTS  
REGISTER OF DEEDS  
ALLEGAN COUNTY, MICH


Register of Deeds Stamp & File Number

LIBER 006 PAGE 95

	A	B	C	D	E	F	G	H	I	J	K	L	M
1													
2	6		5		4		3		2		1		
3													
4	7		8		9		10		11		12		
5													
6	18		17		16		15		14		13		
7													
8	19		20		21		22		23		24		
9													
10	30		29		28		27		26		25		
11													
12	31		32		33		34		35		36		
13													

APPROVED REMONUMENTATION CORNER  
P.A. 345 OF 1990  
ALLEGAN COUNTY

DATE APPROVED NOV. 10, 1998  
COUNTY REP. [Signature]

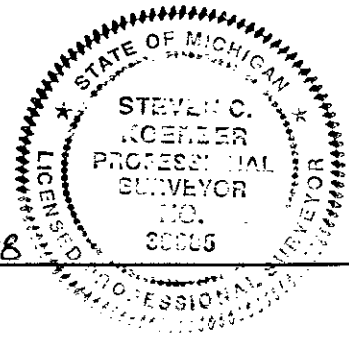

Signed by [Signature]

Date 12-15-1998

Surveyor's Michigan License No. 39085