

**SURVEY  
REMONUMENTATION**

Allegan County Remonumentation

APR 29 1999

**LAND CORNER RECORDATION CERTIFICATE**  
Filing Requirement of Act 74, Mich. P.A. 1970

**SECTION**  
For corners in

Allegan (County)	Located In:	Corner Code #
1. Public Land Survey	T <u>2N</u> R <u>11W</u>	I-1 (NW 2) Martin Twp.
	T <u>    </u> R <u>    </u>	_____
	T <u>    </u> R <u>    </u>	_____
	T <u>    </u> R <u>    </u>	_____
2. Property Controlling in Section	S <u>    </u> T <u>    </u> R <u>    </u>	_____
	S <u>    </u> T <u>    </u> R <u>    </u>	_____
3. Miscellaneous Property in Sec.	S <u>    </u> T <u>    </u> R <u>    </u>	_____
	S <u>    </u> T <u>    </u> R <u>    </u>	_____

FILED  
1/28/1999 2:44:39 PM  
JOYCE A. WATTS  
REGISTER OF DEEDS  
ALLEGAN COUNTY, MICH  
**Register of Deeds Stamp & File Number**

LIBERO 006 PAGE 96

4. Lot No. \_\_\_\_\_, Recorded Plat \_\_\_\_\_  
5. Private Claims \_\_\_\_\_

I, Steven Koerber, in a field survey on Oct. 6, 1998 do hereby state that under requirements of P.A. 74, Michigan P.A. of 1970, the corner points mentioned in lines 1 and 2 above were in conformance with regulations and rules therefore as required in the current manual of survey instructions of the United States Department of the Interior, Bureau of Land Management or by a decree of a Court of Law and/or that the corner points mentioned in lines 3, 4 and 5 above were in conformance with the rules of the Michigan Board of Land Surveyors or by a Decree of a Court of Law; established, re-established, monumented, recovered, found as expressed below:

	A	B	C	D	E	F	G	H	I	J	K	L	M
1													
2	6		5		4		3		2		1		
3													
4	7		8		9		10		11		12		
5													
6	18		17		16		15		14		13		
7													
8	19		20		21		22		23		24		
9													
10	30		29		28		27		26		25		
11													
12	31		32		33		34		35		36		
13													

NOTE: Not more than 2 corners, all in the same town and range, may be recorded on this certificate.

**A. Description of original monument and accessories and/or subsequent restoration:**

I-1 GLO-John Mullet 1826 1. April 1869  
Birch 15 S43W 4 E. Strong  
Do. 7 S48E 34 Dist to H-1= 40.20 ch (Additional info. on back)  
104 links (68.64') East of post (SE 34, Wayland Twp.)

APPROVED REMONUMENTATION CORNER  
P.A. 345 OF 1990  
ALLEGAN COUNTY  
DATE APPROVED OCT. 13, 1998  
COUNTY REP. [Signature]

**B. Description of corner evidence found and/or method applied in restoring or reestablishing corner:**

I-1 Found 1" solid rod in Mon box  
PK nail in NW side P. Pole S70°E 90.75'  
In C/L 124<sup>th</sup> Avenue

This corner is accepted as a careful and faithful perpetuation of the position of the original corner.  
Peer Group approval October 13, 1998.


Dist to H-1 = 2637.59'  
Dist to J-1 = 2641.15'

**C. Description of monument for corner and accessories established to perpetuate locating the position of the corner:**

I-1 Set Standard Allegan Co. Mon. ( 3/4" x 24" Iron Rod with Remon.cap)  
Set nail & Allegan Co. Remon. tag in W. side 12" Cherry S5W 62.01'  
Set nail & Allegan Co. Remon. tag in N. side 18" Cherry N60E 49.00'  
Set nail & Allegan Co. Remon. tag in S. side P.Pole S70E 90.98'  
Set nail & Allegan Co. Remon. tag in E. side 8" Maple N15E 30.20'  
I-13 SW corner Sec. 35-3-11 Wayland Twp. West 68.67'  
On C/L 124<sup>th</sup> Avenue

Signed by [Signature]  
Surveyor's Michigan License No. 39085

Date 12-15-1998

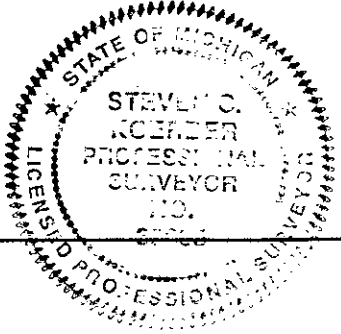

SURVEY  
REMONUMENTATION

APR 29 1980

SECTION

Page 2 of 2

- I-1 MARTIN TWP.
2. L.C.R.C. Liber 3, Page 270 February 12, 1980  
Donald Ratekin  
Found iron, raised with 1" iron  
1" Iron  
PK nail in SE side 12" Cherry N60°E 48.78'  
PK nail in E. side 30" Ash N65°W 75.81'  
PK nail in NW side P. Pole S70°E 90.75'  
In C/L 124<sup>th</sup> Avenue
3. L.C.R.C. Liber 3, Page 321 May 1981  
Paul Van Kooten  
Found 1 1/4" iron on centerline 124<sup>th</sup> and on tree line right of way to South.  
Sq. spike in S. side 34" Ash W-NW 77.12'  
1 1/4" solid rod on fence row to North West 68.68'  
Sq. spike in W'y side 14" Cherry E-NE 48.86'  
PK in S'y side P. Pole E-SE 90.86'
4. Act 132 survey Liber 1003, Page 451 May 5, 1981  
Paul Van Kooten  
Same wits as No. 3 above

LIBRO 006 PAGE 97