

**SURVEY
REMONUMENTATION**

APR 29 1998

Allegan County Remonumentation

SECTION

**LAND CORNER RECORDATION CERTIFICATE
Filing Requirement of Act 74, Mich. P.A. 1970**

For corners in

<u>Allegan</u> (County)	Located In:	Corner Code #
1. Public Land Survey	T <u>2N</u> R <u>11W</u>	<u>K-3</u> (NE corner Sec. 11)
	T <u> </u> R <u> </u>	<u> </u> <u> </u> <u> </u>
	T <u> </u> R <u> </u>	<u> </u> <u> </u> <u> </u>
	T <u> </u> R <u> </u>	<u> </u> <u> </u> <u> </u>
2. Property Controlling in Section	S <u> </u> T <u> </u> R <u> </u>	<u> </u> <u> </u> <u> </u>
	S <u> </u> T <u> </u> R <u> </u>	<u> </u> <u> </u> <u> </u>
3. Miscellaneous Property in Sec.	S <u> </u> T <u> </u> R <u> </u>	<u> </u> <u> </u> <u> </u>
	S <u> </u> T <u> </u> R <u> </u>	<u> </u> <u> </u> <u> </u>
4. Lot No. <u> </u> , Recorded Plat <u> </u>		
5. Private Claims <u> </u>		

FILED
1/28/1999 2:44:39 PM
JOYCE A. WATTS
REGISTER OF DEEDS
ALLEGAN COUNTY, MICH

LIBERO 006 PAGE 500

Register of Deeds Stamp & File Number

I, Steven Koerber, in a field survey on May 29, 1998 do hereby state that under requirements of P.A. 74, Michigan P.A. of 1970, the corner points mentioned in lines 1 and 2 above were in conformance with regulations and rules therefore as required in the current manual of survey instructions of the United States Department of the Interior, Bureau of Land Management or by a decree of a Court of Law and/or that the corner points mentioned in lines 3, 4 and 5 above were in conformance with the rules of the Michigan Board of Land Surveyors or by a Decree of a Court of Law; established, re-established, monumented, recovered, found as expressed below:

NOTE: Not more than 2 corners, all in the same town and range, may be recorded on this certificate.

A	B	C	D	E	F	G	H	I	J	K	L	M
1												
2	6		5		4		3		2		1	
3										●		
4	7		8		9		10		11		12	
5												
6	18		17		16		15		14		13	
7												
8	19		20		21		22		23		24	
9												
10	30		29		28		27		26		25	
11												
12	31		32		33		34		35		36	
13												

A. Description of original monument and accessories and/or subsequent restoration:

- | | | | |
|-----|--|--|---|
| K-3 | GLO- Set Post,
W. Pine 6 N48W 31
Tam. 12 S11E 13
(Additional information on back) | 1. June 1930 Hugh MacDougall
County Drain Notes (no wits) | 2. Wightman old note card
Iron
S.End culvert SW 15.2'
N.End culvert NW 17.3' |
|-----|--|--|---|

B. Description of corner evidence found and/or method applied in restoring or reestablishing corner:


- K-3 Found 3/4" Iron pipe
Fnd. PK nail in P.Pole North 29.80'
Fnd. PK nail in N.side Guy Pole S70°E 74.25'
K-3 to K-4 S00°00'00"W 2652.82'

APPROVED REMONUMENTATION CORNER
P.A. 345 OF 1990
ALLEGAN COUNTY
DATE APPROVED JUNE 9, 1998
COUNTY REP. [Signature]

And is accepted as a careful and faithful perpetuation of the position of the original corner.
Peer Group approval June 9, 1998

C. Description of monument for corner and accessories established to perpetuate locating the position of the corner:

- K-3 Replaced 3/4" Iron pipe with Allegan Co. Mon. (3/4" x 24" Iron Rod with cap)
Set nail & Allegan Co. Remon. Tag in N. side Guy Pole S70°E 74.14'
Set nail & Allegan Co. Remon. Tag in E. side P.Pole N0°E 29.80'
Set nail & Allegan Co. Remon. Tag in E. side Guy pole N35°E 51.09'
Center painted rivet on South end CMP S50°W 35.95'

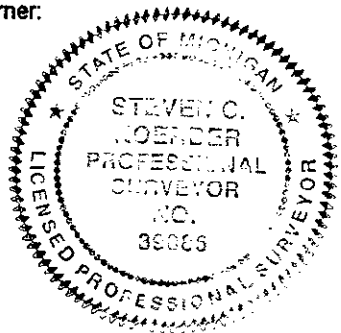

Signed by [Signature] Date 10-12-1998
Surveyor's Michigan License No. 39085

K-3

Page 2 of 2

MARTIN TWP.

3. County Road Commission notes
distance K-2 to K-3 = 2653.7'

4. Donald Ratekin Boundary survey Oct 1, 1964
Dist to J-3 (N 1/4 11) 2639.84'

SURVEY
REMONUMENTATION

APR 29 1966

SECTION

LIBERO 006 PAGES 01