

**SURVEY
REMONUMENTATION**

APR 29 1999

Allegan County Remonumentation

SECTION

**LAND CORNER RECORDATION CERTIFICATE
Filing Requirement of Act 74, Mich. P.A. 1970**

For corners in

<u>Allegan</u> (County)	Located In:	Corner Code #
	2N 11W	K-4 (E 1/4, Sec.11)
1. Public Land Survey	T___ R___	Martin Twp.
	T___ R___	_____
	T___ R___	_____
	T___ R___	_____
2. Property Controlling in Section	S___ T___ R___	_____
	S___ T___ R___	_____
3. Miscellaneous Property in Sec.	S___ T___ R___	_____
	S___ T___ R___	_____

FILED

1/28/1999 2:44:39 PM

JOYCE A. WATTS
REGISTER OF DEEDS
ALLEGAN COUNTY, MICH

LRR0006 PAGE 02

Register of Deeds Stamp & File Number

4. Lot No. _____, Recorded Plat _____
5. Private Claims _____

I, Steven Koerber, in a field survey on May 29, 19 98 do hereby state that under requirements of P.A. 74, Michigan P.A. of 1970, the corner points mentioned in lines 1 and 2 above were in conformance with regulations and rules therefore as required in the current manual of survey instructions of the United States Department of the Interior, Bureau of Land Management or by a decree of a Court of Law and/or that the corner points mentioned in lines 3, 4 and 5 above were in conformance with the rules of the Michigan Board of Land Surveyors or by a Decree of a Court of Law; established, re-established, monumented, recovered, found as expressed below:

NOTE: Not more than 2 corners, all in the same town and range, may be recorded on this certificate.

1	A	B	C	D	E	F	G	H	I	J	K	L	M
2		6		5		4		3		2		1	
3													
4		7		8		9		10		11		12	
5													
6		10		17		16		15		14		13	
7													
8		19		20		21		22		23		24	
9													
10		30		29		28		27		26		25	
11													
12		31		32		33		34		35		36	
13													

A. Description of original monument and accessories and/or subsequent restoration:

- | | | | |
|-----|---|--|--|
| K-4 | GLO- Set Post,
Tam 7 S31E 7
Do. 7 N9W 6
(Additional information on back) | 1. June 1930 Hugh MacDougall
County Drain Notes (no wits) | 2. Wightman old note card
Set 1" Iron (67)
C/I drain West
P. Pole East 36.4'
C/I asphalt West 1.5' |
|-----|---|--|--|

B. Description of corner evidence found and/or method applied in restoring or reestablishing corner:


- K-4 Found 1" Solid Iron rod
Fnd. PK nail in bit. road surface 335.02' South and on line to K-5
Fnd. REM capped rood West 26.35' (per attached survey)
Fnd. REM capped rood 335.02' South and 25.85' West
C/I drain West
K-4 to K-3 N00°00'00"E 2652.82'
K-4 to K-5 S00°00'11"W 2652.71'

APPROVED REMONUMENTATION CORNER
P.A. 345 OF 1990
ALLEGAN COUNTY
DATE APPROVED JUNE 9, 1998
COUNTY REP. [Signature]

And is accepted as a careful and faithful perpetuation of the position of the original corner.
Peer Group approval June 9, 1998

C. Description of monument for corner and accessories established to perpetuate locating the position of the corner:

- K-4 Replaced 1" Solid Iron rod with Allegan Co. Mon. (3/4" x 24" Iron Rod with cap)
Set nail & Allegan Co. Remon. Tag in S. side P. Pole N90°E 36.89'
Set nail & Allegan Co. Remon. Tag in S. side Guy Pole N55°E 36.14'
Set nail & Allegan Co. Remon. Tag in E. side 4"x4" wood post N25°W 125.46'
Fnd. REM capped rood West 26.35'

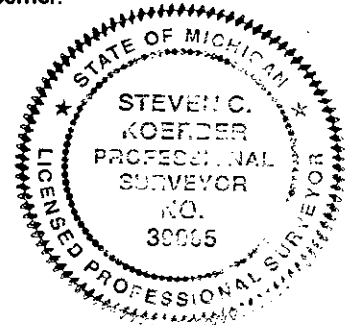

Signed by [Signature]
Surveyor's Michigan License No. 39085

Date 10-12-1998

APR 29 1993

SECTION
K-4 Page 2 of 2

MARTIN TWP.

3. Old Wightman note card distances

K-4 to K-3 = 2652.72'

K-4 to K-5 = 2652.72'

4. Tri-County Land Surveys notes May 12, 1983

Boundary survey (no wits)

5. Wightman Moored Inc. notes 4-29-1992

Boundary survey (no wits)

LIBERO 006 PAGES 03