

**SURVEY  
REMONUMENTATION**

APR 29 1998

Allegan County Remonumentation

**SECTION**

**LAND CORNER RECORDATION CERTIFICATE  
Filing Requirement of Act 74, Mich. P.A. 1970**

For corners in

Allegan (County)	Located In:	Corner Code #
	2N 11W	K-5 (SE corner Sec.11)
1. Public Land Survey	T___ R___	Martin Twp.
	T___ R___	_____
	T___ R___	_____
	T___ R___	_____
2. Property Controlling in Section	S___ T___ R___	_____
	S___ T___ R___	_____
3. Miscellaneous Property in Sec.	S___ T___ R___	_____
	S___ T___ R___	_____

FILED

1/28/1999 2:44:39 PM

JOYCE A. WATTS  
REGISTER OF DEEDS  
ALLEGAN COUNTY - MICH

LIBR0006 PAGE 504

Register of Deeds Stamp & File Number

4. Lot No. \_\_\_\_\_, Recorded Plat \_\_\_\_\_  
5. Private Claims \_\_\_\_\_

I, Steven Koerber, in a field survey on May 29, 1998 do hereby state that under requirements of P.A. 74, Michigan P.A. of 1970, the corner points mentioned in lines 1 and 2 above were in conformance with regulations and rules therefore as required in the current manual of survey instructions of the United States Department of the Interior, Bureau of Land Management or by a decree of a Court of Law and/or that the corner points mentioned in lines 3, 4 and 5 above were in conformance with the rules of the Michigan Board of Land Surveyors or by a Decree of a Court of Law; established, re-established, monumented, recovered, found as expressed below.

NOTE: Not more than 2 corners, all in the same town and range, may be recorded on this certificate.

	A	B	C	D	E	F	G	H	I	J	K	L	M
1													
2	6	5	4	3	2	1							
3													
4	7	8	9	10	11	12							
5													
6	18	17	16	15	14	13							
7													
8	19	20	21	22	23	24							
9													
10	30	29	28	27	26	25							
11													
12	31	32	33	34	35	36							
13													

A. Description of original monument and accessories and/or subsequent restoration:

- |  |   |   |
|--|---|---|
| <p>K-5 GLO- Set Post,<br/>Elm 7 S52W 92<br/>Tam 12 N41W 193<br/>(Additional information on back)</p> | <p>1. April 26, 1925 Hugh MacDougall<br/>County Drain Notes (no wits)</p> | <p>2. Wightman old note card<br/>1" Solid Iron (4" below pav't)<br/>SE cor. headwall N45°E 25.2'<br/>SW cor. headwall N45°W 24.7'<br/>27" Maple N50°W 53.4'</p> |
|--|---|---|

B. Description of corner evidence found and/or method applied in restoring or reestablishing corner:

- K-5 Found 1" Solid Iron rod  
Fnd. SE cor. headwall N45°E 25.2'  
Fnd. SW cor. headwall N45°W 24.7'

K-5 to K-4 N00°00'11"E 2652.71'  
K-5 to K-6 S00°31'52"W 2695.53'


APPROVED REMONUMENTATION CORNER  
P.A. 345 OF 1990  
ALLEGAN COUNTY

DATE APPROVED JUNE 9, 1998  
COUNTY REP. [Signature]

And is accepted as a careful and faithful perpetuation of the position of the original corner.  
Peer Group approval June 9, 1998

C. Description of monument for corner and accessories established to perpetuate locating the position of the corner:

- K-5 Replaced 1" Solid Iron rod with Allegan Co. Mon. (3/4" x 24" Iron Rod with cap)  
Set nail & Allegan Co. Remon. Tag in NE side P. Pole N45°E 57.61'  
Set nail & Allegan Co. Remon. Tag in SE side P. Pole S50°W 53.48'  
Stop sign post N65°E 38.7'  
SE cor. headwall N45°E 25.2'  
SW cor. headwall N45°W 24.7'

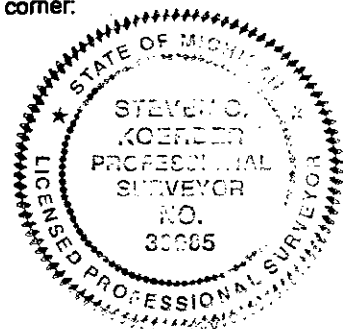

Signed by [Signature]  
Surveyor's Michigan License No. 39085

Date 10-12-1998

APR 29 1980

K-5 SECTION  
Page 2 of 2

MARTIN TWP.

## 3. Old Wightman note card distances

K-4 to K-5= 2652.72'

## 4. Donald Ratekin 11-24-1971

Boundary survey

1" iron

same wits as No. 5 below

## 5. L.C.R.C. L.1, Pg. 229 (4-18-1972)

Donald Ratekin

Found 1" iron 4" below pavement

SE cor. headwall N45°E 25.2'

SW cor. headwall N45°W 24.7'

27" Maple N50°W 53.4'

P. Pole S45°W 37.3'

St. Sign S45°E 43.1'

## 6. John Dillingham 4-13-1979

Boundary survey (no wits)

## 7. John Dillingham 4-19-1979

Boundary survey

witnesses same as No. 5 above

## 8. John Dillingham 9-19-1979

Boundary survey (no wits)

## 9. Tri-County Land Surveys 4-17-1984

Boundary survey

1" iron

No wits

## 10. L.C.R.C. L. 3, Pg. 314 7-22-1980

Dave Peabody (Appears to be wits to another corner)

Fn. RR Spike

in occupation to North

C/L road South 6'

16" Walnut N 21.6'

20" Walnut S20°W 23.5'

LIBR0006 PAGE 05