

**SURVEY
REMONUMENTATION**

APR 29 1998

Allegan County Remonumentation

SECTION

**LAND CORNER RECORDATION CERTIFICATE
Filing Requirement of Act 74, Mich. P.A. 1970**

For corners in

Allegan (County)	Located in:	Corner Code #
	2N 11W	K-6 (E 1/4 corner Sec. 14)
1. Public Land Survey	T___ R___	Martin Twp.
	T___ R___	_____
	T___ R___	_____
	T___ R___	_____
2. Property Controlling in Section	S___ T___ R___	_____
	S___ T___ R___	_____
3. Miscellaneous Property in Sec.	S___ T___ R___	_____
	S___ T___ R___	_____

FILED

1/28/1999 2:44:39 PM

JOYCE A. WATTS
REGISTER OF DEEDS
ALLEGAN COUNTY, MICH

Register of Deeds Stamp & File Number

LIBERO 006 PARE506

4. Lot No. _____, Recorded Plat _____
5. Private Claims _____

	A	B	C	D	E	F	G	H	I	J	K	L	M
1													
2	6		5		4		3		2		1		
3													
4	7		8		9		10		11		12		
5													
6	18		17		16		15		14		13		
7													
8	19		20		21		22		23		24		
9													
10	30		29		28		27		26		25		
11													
12	31		32		33		34		35		36		
13													

I, Steven Koerber, in a field survey on May 29, 1998 do hereby state that under requirements of P.A. 74, Michigan P.A. of 1970, the corner points mentioned in lines 1 and 2 above were in conformance with regulations and rules therefore as required in the current manual of survey instructions of the United States Department of the Interior, Bureau of Land Management or by a decree of a Court of Law and /or that the corner points mentioned in lines 3, 4 and 5 above were in conformance with the rules of the Michigan Board of Land Surveyors or by a Decree of a Court of Law, established, re-established, monumented, recovered, found as expressed below:

NOTE: Not more than 2 corners, all in the same town and range, may be recorded on this certificate.

A. Description of original monument and accessories and/or subsequent restoration:

- K-6 GLO- Set Post, Elm 8 S5W 125 Do 6 N86 1/2E 180
- 1. Wightman old note card (no date) stake

APPROVED REMONUMENTATION CORNER
P.A. 345 OF 1990
ALLEGAN COUNTY

DATE APPROVED Aug 11, 1998
COUNTY REP. [Signature]

B. Description of corner evidence found and/or method applied in restoring or reestablishing corner:


- K-6 Nothing found at corner position
- K-6 to K-5 N00°31'52"E 2695.53'
- K-6 to K-7 S00°27'11"W 2609.08'

Reestablished the monument by proportionate measure. Found Iron boat spike at 1304.54 feet North of K-7, at the 1/8th line occupation to the West. Set the monument by doubling the distance from the found iron boat spike and K-7, and by holding the line extended between these two point, to set the monument at K-6.

And is accepted as a careful and faithful reestablishment of the position of the original corner.
Peer Group approval August 11, 1998

C. Description of monument for corner and accessories established to perpetuate locating the position of the corner:

- K-6 Set Allegan Co. Mon. (3/4" x 24" Iron Rod with cap)
- Set nail & Allegan Co. Remon. Tag in S. side P. Pole N40°W 49.33'
- Set nail & Allegan Co. Remon. Tag in N. side tri-18" Maple S50°E 48.17'
- Set nail & Allegan Co. Remon. Tag in E. side 12" Maple N35°E 65.94'
- SW corner E. side conc. bridge headwall N75°E 11.92'
- NE corner W. side conc. bridge headwall N30°E 20.83'
- C/I bridge deck and E-W ditch North 10'

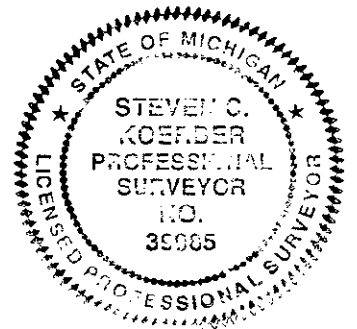

Signed by [Signature]
Surveyor's Michigan License No. 39085

Date 10-12-1998