

**SURVEY
REMONUMENTATION**

Allegan County Remonumentation

APR 29 1999

LAND CORNER RECORDATION CERTIFICATE
Filing Requirement of Act 74, Mich. P.A. 1970

SECTION

For corners in

Allegan (County)	Located in:	Corner Code #
	2N 11W	K-7 (SE corner Sec.14)
1. Public Land Survey	T ___ R ___	Martin Twp.
	T ___ R ___	_____
	T ___ R ___	_____
	T ___ R ___	_____
2. Property Controlling in Section	S ___ T ___ R ___	_____
	S ___ T ___ R ___	_____
3. Miscellaneous Property in Sec.	S ___ T ___ R ___	_____
	S ___ T ___ R ___	_____

FILED

1/28/1999 2:44:39 PM

JOYCE A. WATTS
REGISTER OF DEEDS
ALLEGAN COUNTY, MICH

LIBERO 006 PAGES 07

Register of Deeds Stamp & File Number

4. Lot No. _____, Recorded Plat _____
5. Private Claims _____

I, Steven Koerber, in a field survey on May 29, 1998 do hereby state that under requirements of P.A. 74, Michigan P.A. of 1970, the corner points mentioned in lines 1 and 2 above were in conformance with regulations and rules therefore as required in the current manual of survey instructions of the United States Department of the Interior, Bureau of Land Management or by a decree of a Court of Law and /or that the corner points mentioned in lines 3, 4 and 5 above were in conformance with the rules of the Michigan Board of Land Surveyors or by a Decree of a Court of Law; established, re-established, monumented, recovered, found as expressed below:

NOTE: Not more than 2 corners, all in the same town and range, may be recorded on this certificate.

	A	B	C	D	E	F	G	H	I	J	K	L	M
1													
2	6		5		4		3		2		1		
3													
4	7		8		9		10		11		12		
5													
6	18		17		16		15		14		13		
7													
8	19		20		21		22		23		24		
9													
10	30		29		28		27		26		25		
11													
12	31		32		33		34		35		36		
13													

A. Description of original monument and accessories and/or subsequent restoration:

- | | | |
|--|---|--|
| <p>K-7 GLO- Set Post,
W. Ash 18 S1W 21
Elm 7 N68E 27</p> | <p>1. Co. Road Com.
Iron Pin
NW 79.3 SE Cor. Hse
SW 134.8 NE cor storage bldg</p> | <p>2. Wightman old note card (1971)
Fnd 1" pipe raised with large boat spike
SE cor hse (new addition) N35°W 70.7'
NE cor bldg. S45°W 134.7'
Street sign S45°E 49.2'</p> |
|--|---|--|

B. Description of corner evidence found and/or method applied in restoring or reestablishing corner:

- K-7 Found 1 1/2" O.D. Iron Pipe
SE cor hse (new addition) N35°W 70.7'
NE cor bldg. S45°W 134.7'


K-7 to K-6 N00°27'11"E 2609.08'

APPROVED REMONUMENTATION CORNER
P.A. 345 OF 1990
ALLEGAN COUNTY
DATE APPROVED JUNE 9, 1998
COUNTY REP. [Signature]

And is accepted as a careful and faithful perpetuation of the position of the original corner.
Peer Group approval June 9, 1998

C. Description of monument for corner and accessories established to perpetuate locating the position of the corner:

- K-7 Replaced 1 1/2" pipe with Allegan Co. Mon. (3/4" x 24" Iron Rod with cap)
Set nail & Allegan Co. Remon. Tag in E. side P. Pole N35°W 55.91'
Set nail & Allegan Co. Remon. Tag in E. side P. Pole S25°W 162.91'
Stop sign post N65°E 38.7'
SE cor hse (new addition) N35°W 70.7'
NE cor bldg. S45°W 134.7'

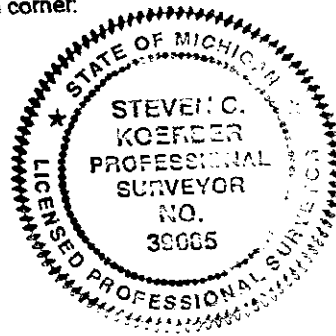

Signed by [Signature]
Surveyor's Michigan License No. 39085

Date 10-12-1998

3. Donald Ratekin 10-13-1971

Boundary survey

same wits as No. 2 above

4. L.C.R.C. L.1, Pg. 226 (4-18-1972)

Donald Ratekin

Found 1" iron raised with large boat spike

SE cor hse (new addition) N35°W 70.7'

NE cor bldg. S45°W 134.7'

Street sign S45°E 49.2'

5. Donald Ratekin 3-17-1977

Boundary survey

same wits as No. 2 above

6. Wightman Moored Land Surveys 5-13-1992

Section breakdown notes

Fnd. iron

No wits

SURVEY
REMONUMENTATION

APR 29 1993

SECTION