Allegan County Remonumentation
LAND CORNER RECORDATION CERTIFICATE
Filing Requirement of Act 74, Mich. P.A. 1970

For corners in Allegan (County)

	Located In:	Corner Code #
1. Public Land Survey	T 2N R 11W	L-1 (N ½, 1)
	T ___ R ___	Martin Twp.
	T ___ R ___	
	T ___ R ___	
2. Property Controlling	S ___ T ___ R ___	
in Section	S ___ T ___ R ___	
3. Miscellaneous	S ___ T ___ R ___	
Property in Sec.	S ___ T ___ R ___	

1995 DEC 14 PM 2:35
FILED
REGISTER OF DEEDS ALLEGAN CO.
Register of Deeds Stamp & File Number

SURVEY & REMONUMENTATION
APR 29 1996
COMMISSION

4. Lot No. _____, Recorded Plat _____
5. Private Claims _____

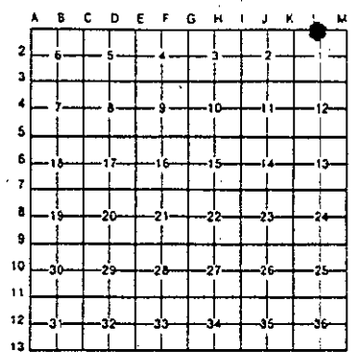

I, John C. Bueche, in a field survey on July 12, 19 95, do hereby certify that under requirements of P.A. 74, Michigan P.A. of 1970, the corner points mentioned in lines 1 and 2 above were in conformance with regulations and rules therefore as required in the current manual of survey instructions of the United States Department of the Interior, Bureau of Land Management or by a decree of a Court of Law and/or that the corner points mentioned in lines 3, 4 and 5 above were in conformance with the rules of the Michigan Board of Land Surveyors or by a Decree of a Court of Law; established, re-established, monumented, re-monumented, recovered, found as expressed below:

NOTE: **Not more than 4 corners, all in the same town and range, may be recorded on this certificate.**

A. Description of original monument and accessories and/or subsequent restoration:

L-1 GLO Not Set

Survey L1233, P588
PK, March, 1989
S 1/4 cor. Sec. 36, 3-11 W 33.75'
Nail in SW side 30" Oak S 25 E 35.40'
Nail in N side E'ly PP S 68 W 88.12'
Nail in SW side PP N 44 W 46.97'

B. Description of corner evidence found and/or method applied in restoring or reestablishing corner:

L-1 Found PK as per above wit.
PK is on line btween S 1/4 cor. Sec. 36, 3-11 & iron in Mon. Box 1392.17' East (Patterson N-S) which is being held for South line of Township 3-11

This position not established by original government surveyors. This monument is accepted as the best available evidence of the position of the corner.

APPROVED REMONUMENTATION CORNER
P.A. 345 OF 1990
ALLEGAN COUNTY
DATE APPROVED 8-14-95
COUNTY REP. [signature]

C. Description of monument for corner and accessories established to perpetuate locating the position of the corner:

L-1 Replaced PK w/Allegan Co. Mon. (3/4" x 24" w/cap in bit.)
Nail & Allegan Co. Remon. Tag in N side PP S 70° W 102.87'
Cor. metal bldg. S 20° E 100.79'
SW cor. metal bldg. N 55° E 175.88'
SW cor. metal bldg. West end N 5° W 134.80'
On C/L bit. E-W, on fence South
Allegan Co. Mon. S 1/4 cor. 36, 3-11 West 33.75'

STATE OF MICHIGAN
JOHN C. BUECHE
LAND SURVEYOR
No. 13027
REGISTERED LAND SURVEYOR

Signed by John C Bueche
John C. Bueche
Date Oct 2, 1995
Surveyor's Michigan License No. 13027

FORM APPROVED BY MICHIGAN STATE BOARD OF SURVEYORS, JAN. 28, 1971
REVISED MAY 14, 1975
REVISED JAN., 1983