

MAR 07 2000

ALLEGAN COUNTY REMONUMENTATION
LAND CORNER RECORDATION CERTIFICATE
FILING REQUIREMENT OF ACT 74, MICH. P. A. 1970

SECTION

FOR CORNERS IN: ALLEGAN COUNTY	LOCATED IN:	CORNER CODE #
1. Public Land Survey	T. 2N R. 11W	M-5
SE COR., SEC. 12	T..... R.....
NE COR., SEC. 13	T..... R.....
MARTIN TWP.	T..... R.....
2. Property Controlling in section	S.....T.....R.....
	S.....T.....R.....
3. Miscellaneous Property in Sec.	S.....T.....R.....
4. Lot No....., Recorded Plat.....		
5. Private Claims.....		

REGISTER OF DEEDS
ALLEGAN COUNTY MI

00 FEB -1 AM 8:48

FILED

REGISTER OF DEEDS STAMP & FILE NUMBER

	A	B	C	D	E	F	G	H	I	J	K	L	M
2	6		5		4		3		2		1		
3													
4	7		8		9		10		11		12		
5													
6	18		17		16		15		14		13		
7													
8	19		20		21		22		23		24		
9													
10	30		29		28		27		26		25		
11													
12	31		32		33		34		35		36		
13													

I, Raymond Moored in a field survey on Sept. 7, 1999 do hereby state that under requirements of P.A 74, Michigan P.A of 1970, corner points mentioned in lines 1 and 2 above were in conformance with regulations and rules therefore as required in the current manual of survey instructions of the United States Department of the Interior, Bureau of Land Management or by a decree of a Court of Law and/or that the corner points mentioned in the lines 3, 4, and 5 above were in conformance with the rules of the Michigan Board of Land Surveyors or by a Decree of a Court of Law; established, monumented, recovered, found as expressed below.

Note: Not more than 2 corners, all the same town and range, may be recorded on this certificate.

A. Description of original monument and accessories and/or subsequent restoration:
SEE BACK OF SHEET FOR CORNER HISTORY

APPROVED REMONUMENTATION CORNER
P.A. 345 OF 1990
ALLEGAN COUNTY
DATE APPROVED OCT. 12, 1999
COUNTY REP. [Signature]

B. Description of corner evidence found and/or method applied in restoring or reestablishing corner:
FD. 1 1/2" IRON FOR CORNER PER WITNESSES IN THE ITEMS # 4&5 ABOVE
ALL WITNESSES STILL EXISTING.
ACCEPTED POSITION AS A CAREFUL & FAITHFUL PERPETUATION OF THE POSITION OF THE ORIGINAL CORNER.
REMOVED 1 1/2" IRON AND SET STANDARD ALLEGAN COUNTY REMON IRON W/CAP.
APPROVED BY ALLEGAN COUNTY REMON PEER GROUP ON OCT. 12, 1999.

TOTAL TRAVERSING= 2659.87' ON ROAD

C. Description of monument for corner and accessories established to perpetuate locating the position of the corner:

- SET STANDARD 3/4" X 24" ALLEGAN COUNTY REMONUMENTATION IRON W/CAP
- FD. NAIL IN P. POLE N 45 W 56.6'
- FD. NAIL IN P. POLE S 45 W 43.45'
- FD. NAIL IN P. POLE N 45 E 64.92'
- A-5, T2N, R10W, SOUTH 25.02'
- IN CENTERLINE OF PATTERSON ROAD AND 120th AVENUE

[Signature] Date 11/10/99

Surveyors License No. 26463



RF

1988 07 2000

SECTION

GOVERNMENT CORNER HISTORY
EAST ¼ CORNER OF SECTION 12,
TOWN 2 NORTH, RANGE 11 WEST,
M-5

1. GLO NOTES CIRCA 1830 80 CH'S SET POST COR SEC'S 12 & 13
WITNESSES: W OAK 9 S 20 W 79.5
TAMARACK 6 N 42 3/4 W 911

2. GEO. BURGESS, SURVEYOR; 5-4-1917
ORANGEVILLE CREEK DRAIN CROSSES COUNTY LINE 93' NORTH OF SECTION COR.

3. HUGH MAC DOUGALL; COUNTY SURVEYOR, 5-17-1926 NOTES:
FD. IRON FOR CORNER (NO WIT'S) NOTES JOG TO BARRY COR. S 25'


4. D.A. RATEKIN, CO. SURVEYOR
SECTION CARD INFORMATION 1 ½ INCH IRON (WILLIAMS & WORKS, CIRCA 1976)
POWER POLE N 45°W 56.65 FEET
POWER POLE S 45°W 43.45 FEET
POWER POLE N 45° E 64.93 FEET
THE CENTERLINE OF PATTERSON ROAD AND 120th AVENUE

5. L.C.R.C. RECORDED BY JOHN A. MERDZINSKI 11-12-1976
(LIBER 3, PAGE 149)
NOTES WITNESSES SAMES AS ITEM # 4

6. L.C.R.C. RECORDED BY DAVID PEABODY, SURVEYOR 7-22-80
(LIBER 3, PAGE 314)
NOTES BOAT SPIKE BURIED 1' DEEP; 1' FROM SEAL COAT SURFACE OF 102nd AVENUE
WEST OF U.S. 131 FREEWAY BRIDGE
N 75°E 36.25 FEET TO N. PIERS.W. CORNER
S. 44°E 43.34 FEET TO S. PIER N.W. CORNER
S 04°E 12.24 FEET TO N.W. CORNER
(RECORDED WRONG - WITNESSES ARE NOT FOR THIS CORNER)

7. HOLLAND ENGINEERING SECTION CARD
NOTES SAMES WITNESSES AS D.F. PEABODY

8. WIGHTMAN-MOORED, INC. SURVEY 5-15-92
NOTES CORNER, NO WITNESSES

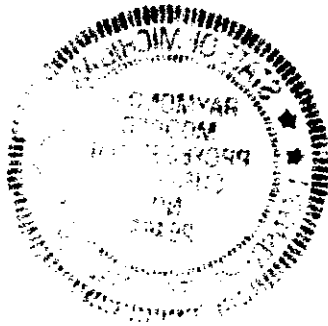

LIBER 007 PAGE 381