

MAR 07 2000

SECTION

Allegan County Remonumentation
LAND CORNER RECORDATION CERTIFICATE
Filing Requirement of Act 74, Mich. P.A. 1970

For corners in
Allegan

For corners in Allegan (County)	Located In:		Corner Code #
	2N	12W	A-9 (NW 30) Watson Twp.
1. Public Land Survey	T	R	_____
	T	R	_____
	T	R	_____
	T	R	_____
2. Property Controlling in Section	S	T	_____
	S	T	_____
3. Miscellaneous Property in Sec.	S	T	_____
	S	T	_____

REGISTER OF DEEDS
ALLEGAN COUNTY, MICHIGAN
James A. Coyle

00 FEB - 1 AM 8:51

FILED

INDEXED 00 / MAR 07 2000

Register of Deeds Stamp & File Number

4. Lot No. _____, Recorded Plat _____
5. Private Claims _____

I, Steven Koerber, in a field survey on August 4, 1999 do hereby state that under requirements of P.A. 74, Michigan P.A. of 1970, the corner points mentioned in lines 1 and 2 above were in conformance with regulations and rules therefore as required in the current manual of survey instructions of the United States Department of the Interior, Bureau of Land Management or by a decree of a Court of Law and/or that the corner points mentioned in lines 3, 4 and 5 above were in conformance with the rules of the Michigan Board of Land Surveyors or by a Decree of a Court of Law; established, re-established, monumented, recovered, found as expressed below:

NOTE: Not more than 2 corners, all in the same town and range, may be recorded on this certificate.

	A	B	C	D	E	F	G	H	I	J	K	L	M
1													
2	6		5		4		3		2		1		
3													
4	7		8		9		10		11		12		
5													
6	18		17		16		15		14		13		
7													
8	19		20		21		22		23		24		
9													
10	30		29		28		27		26		25		
11													
12	31		32		33		34		35		36		
13													

A. Description of original monument and accessories and/or subsequent restoration:

A-9	1831 GLO - L. Lyons DS Set post 80 lks N. of post Pine 20 S79E 34 Tamarak 11 N8E 50	1. Old Drain Notes 1908 No wits Drain terminates 113.09 rods East & 2 rods North of NW corner Sec. 30	2. Old notes from old Co. Surveyor Stone S11°W 106.46' U.S.G.S. BM N63°W 32.74' 36" Elm N39°E 62.44' P.Pole
-----	--	---	---

APPROVED REMONUMENTATION CORNER
P.A. 345 OF 1990
ALLEGAN COUNTY
DATE APPROVED AUG. 10, 1999
COUNTY REP. [Signature]


(Additional info. on back of sheet)

B. Description of corner evidence found and/or method applied in restoring or reestablishing corner:

A-9 Found large bolt spike in mon. box - 2.58' East of Range line
C/L highway M-222 South 23.37'
Allegan Twp. Corner South 52.80'
C/L top angle iron fence post N-NE 156.85'
Set Standard Allegan Co. Mon. (3/4" x 24" Iron Rod with Remon.cap) on a line as defined by the SE corner of Section 24, Allegan Twp. (M-9) and the East 1/4 corner of Section 24, Allegan Twp. (M-8) at the distance of 52.80 feet north of the SE corner of Sec. 24, Allegan Twp. (M-9)
This corner is accepted as a careful and faithful perpetuation of the position of the original corner.
Peer Group approval November 9, 1999.
Dist to A-10 = 2628.35'

C. Description of monument for corner and accessories established to perpetuate locating the position of the corner:

A-9	Set Standard Allegan Co. Mon. (3/4" x 24" Iron Rod with Remon.cap)	
	Set nail & Allegan Co. Remon. tag in NW side P.Pole	N33°E 79.65'
	Set nail & Allegan Co. Remon. tag in NE side P.Pole	S23°E 112.07'
	Set nail & Allegan Co. Remon. tag in NW side twin 12' Ash	S23°W 210.09'
	Top "L" angle of steel "L" angle fence post	N11°W 159.06'
	SE corner Sec. 24, Allegan Twp. (M-9)	South 52.80'
	Closing corner monument - Large bolt spike in mon. Box	East 2.58'

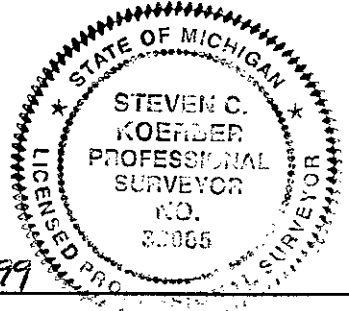

Signed by [Signature]
Surveyor's Michigan License No. 39085

Date 12-17-1999

MAR 07 2000

SECTION

Page 2 of 2

A-9 WATSON TWP.

3. Old note card witnesses
9-29-1967
Large boat spike
1' North of asphalt apron
S11°W 106.46' U.S.G.S. BM
M-9 Allegan Twp. South 52.80'

4. 6-6-1986
Tri-County Land Surveys -Boundary survey
No. wits.
23.37' South C/L Highway M-118
52.37' South NE corner Sec. 25, Allegan Twp

5. 9-17-1993 Act 132 survey
Kirk Van Order
Fnd. Boat spike in mon. box
C/L highway M-222 South 23.37'
Allegan Twp. Corner South 52.80'
C/L top angle iron fence post N-NE 156.85'
C/L top tele. Pedistal NW 169.71'
Nail & tag in W. side Power Pole SE 111.30'

6. MDOT highway notes
M-9 Allegan Twp. Corner South 52.80'

LIBR000 / PAGE 52