

2000 07 2000

SECTION

Allegan County Remonumentation
LAND CORNER RECORDATION CERTIFICATE
Filing Requirement of Act 74, Mich. P.A. 1970

REGISTER OF DEEDS
ALLEGAN COUNTY MICH.

00 FEB - 1 AM 8 52

FILED
INDEXED 07 PAGE 55

For corners in
Allegan

For corners in Allegan (County)	Located in:	Corner Code #	
		2N	12W
1. Public Land Survey	T	R	A-12 (W 1/4 31) Watson Twp.
	T	R	
	T	R	
	T	R	
2. Property Controlling in Section	S	T	R
	S	T	R
3. Miscellaneous Property in Sec.	S	T	R
	S	T	R

Register of Deeds Stamp & File Number

4. Lot No. _____, Recorded Plat _____
5. Private Claims _____

I, Steven Koerber, in a field survey on August 4, 19 99 do hereby state that under requirements of P.A. 74, Michigan P.A. of 1970, the corner points mentioned in lines 1 and 2 above were in conformance with regulations and rules therefore as required in the current manual of survey instructions of the United States Department of the Interior, Bureau of Land Management or by a decree of a Court of Law and /or that the corner points mentioned in lines 3, 4 and 5 above were in conformance with the rules of the Michigan Board of Land Surveyors or by a Decree of a Court of Law; established, re-established, monumented, recovered, found as expressed below:

NOTE: Not more than 2 corners, all in the same town and range, may be recorded on this certificate.

	A	B	C	D	E	F	G	H	I	J	K	L	M
1													
2	6		5		4		3		2		1		
3													
4	7		8		9		10		11		12		
5													
6	10		17		16		15		14		13		
7													
8	19		20		21		22		23		24		
9													
10	30		29		28		27		26		25		
11													
12	31		32		33		34		35		36		
13													

A. Description of original monument and accessories and/or subsequent restoration:
A-12 GLO - corner not set


B. Description of corner evidence found and/or method applied in restoring or reestablishing corner:

A-12 Found nothing at corner position
 Old fence line to East 53'± North of M-12 Allegan Twp.
 Set Standard Allegan Co. Mon. (3/4" x 24" Iron Rod with Remon.cap) on a line as defined by East 1/4 corner of Section 36, Allegan Twp (M-12) and the NE corner of Sec. 36, Allegan Twp, (M-11) at the split of jog from GLO notes of Section 31, Watson Twp. Corner position is 53.46' North of the East 1/4 corner of Section 36, Allegan twp. (M-12)
 This position not established by original government surveyors. This monument is accepted as the best available evidence of the position of the corner.
 Peer Group approval August 10, 1999.
 Dist to A-11 = 2714.19'
 Dist to A-13 = 2714.19'

APPROVED REMONUMENTATION CORNER
 P.A. 3-5 OF 1990
 ALLEGAN COUNTY
 DATE APPROVED AUG. 10, 1999
 COUNTY REP. [Signature]

C. Description of monument for corner and accessories established to perpetuate locating the position of the corner:

A-12 Set Standard Allegan Co. Mon. (3/4" x 24" Iron Rod with Remon.cap)
 Set nail & Allegan Co. Remon. tag in N. side 8" Ash N60°W 35.78'
 Set nail & Allegan Co. Remon. tag in NW side 12" Hickory S35°W 64.59'
 Set nail & Allegan Co. Remon. tag in N. side 14" Oak S85°E 52.44'
 Set nail & Allegan Co. Remon. tag in W. side P.Pole S20°W 104.56'
 East 1/4 corner Section 36, Allegan Twp. (M-12) South 53.46'
 On tree and fence line to the East
 On centerline N-S gravel road

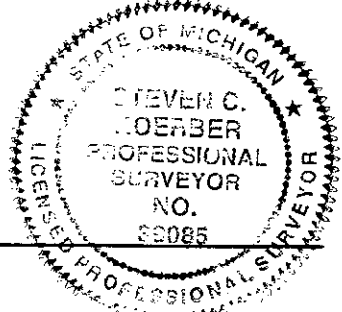

Signed by [Signature]
 Surveyor's Michigan License No. 39085

Date 12-17-1999