

ALLEGAN COUNTY REMONUMENTATION
 LAND CORNER RECORDATION CERTIFICATE
 Filing Requirement of Act 74, Mich. P.A. 1970

113

For corners in

<u>ALLEGAN</u> (County)	Located In:	Corner Code #
1. Public Land Survey	T- <u>2N</u> R- <u>12W</u>	<u>B-13 S1/4-31</u> <u>WATSON TWP</u>
	T _____ R _____	_____
	T _____ R _____	_____
2. Property Controlling in Section	S _____ T _____ R _____	_____
	S _____ T _____ R _____	_____
3. Miscellaneous Property in Sec.	S _____ T _____ R _____	_____
	S _____ T _____ R _____	_____

1994 APR 28 AM 9:46
 REGISTER OF DEEDS
 ALLEGAN COUNTY, MICHIGAN
 REGISTER OF DEEDS Stamp & File Number

FILED

4. Lot No. _____, Recorded Plat _____
 5. Private Claims _____

I, BASIL ADDRESS, in a field survey on FEBRUARY 9, 1994, do hereby certify that under requirements of P.A. 74, Michigan P.A. of 1970, the corner points mentioned in lines 1 and 2 above were in conformance with regulations and rules therefore as required in the current manual of survey instructions of the United States Department of the Interior, Bureau of Land Management or by a decree of a Court of Law and/or that the corner points mentioned in lines 3, 4 and 5 above were in conformance with the rules of the Michigan Board of Land Surveyors or by a Decree of a Court of Law; established, re-established, monumented, re-monumented, recovered, found as expressed below:

A	B	C	D	E	F	G	H	I	J	K	L	M
2	6	5	4	3	2	1						
3												
4	7	8	9	10	11	12						
5												
6	18	17	16	15	14	13						
7												
8	19	20	21	22	23	24						
9												
10	30	29	28	27	26	25						
11												
12	31	32	33	34	35	36						
13												

NOTE: Not more than 4 corners, all in the same town and range, may be recorded on this certificate.

A. Description of original monument and accessories and/or subsequent restoration:
 G.L.O. DEC. 1830 LUCIUS LYON, DS
 WEST SOUTH SIDE OF SEC-31, T-2N, R-12W
 40.00 SET QR. SEC. POST
 WITNESSES: BEECH 10 N 22 E 25LKS.
 BEECH 12 N 55 W 121ks.

APPROVED REMONUMENTATION CORNER
 P.A. 345 OF 1990
 ALLEGAN COUNTY
 DATE APPROVED 3-9-94
 COUNTY REP. [Signature]

CONTINUED ON BACK OF CERTIFICATE


B. Description of corner evidence found and/or method applied in restoring or reestablishing corner:
 FD. 3/4" IRON
 FIT REMAINING WITNESSES FROM L.C.R.C.

THIS CORNER IS ACCEPTED AS A CAREFUL AND FAITHFUL REESTABLISHMENT OF THE POSITION OF THE ORIGINAL CORNER.

APPROVED BY THE ALLEGAN COUNTY REMONUMENTATION PEER GROUP 3-9-94.

C. Description of monument for corner and accessories established to perpetuate locating the position of the corner:

REPLACED 3/4" IRON W/ STD. ALLEGAN CO. MON. (3/4" x 36" STEEL PIN & CAP)
 NE COR CONC FND (HSE #2284) S 40 E 229.21'
 NAIL & REMON. WASHER E SDE PP S 05 W 294.96'
 NAIL & REMON. WASHER NW SDE 24" OAK S 50 W 108.49'
 NAIL & REMON. WASHER W SDE PP N 15 W 193.63'
 NAIL & REMON. WASHER W SDE 14" MAPLE N 20 E 57.59'
 IN LINE W/ OCC. TO SOUTH
 IN C/L 112TH AVE. (GRAVEL)
 STD. ALLEGAN CO. MON. (N1/4 COR, SEC-6, OTSEGO TWP) WEST 82.87'

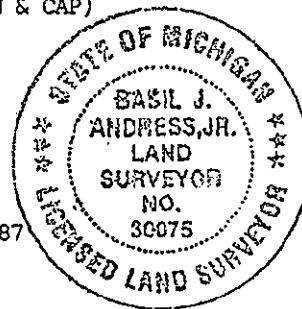

Signed by [Signature] Date 4-11-94
 Surveyor's Michigan License No. 30075

FORM APPROVED BY MICHIGAN STATE BOARD OF LAND SURVEYORS, JAN. 28, 1971
 REVISED MAY 14, 1975
 REVISED JAN., 1983

LISFR 004 PAGE 374

SHEET 1 OF 2

A. DESCRIPTION OF ORIGINAL MONUMENT AND ACCESSORIES AND/OR SUBSEQUENT RESTORATION.

9-18-72 D. A. RATEKIN, CS

L.C.R.C. L-2,P-30

"CORNER SET ON PROPORTIONAL DISTANCE FOR THE MILE AND 1403.16'
NORTH OF PROPERTY LINE TO SOUTH AS PER NOTES."

3/4" IRON

NAIL ON S SIDE OF 20" HICKORY N50E 69.15'

" " SW " " 12" ASH S30E 24.17'

" " N " " P. POLE S70W 75.23'

IN CL OF ROAD

DIST. TO TOWNSHIP COR. 2651.31'

DIST EAST TO 1/8 POST 1317.42'

CONT. EAST TO 1/4 COR 1317.42'

SURVEY &
REMONSTRATION

NOV 1 1985

COMMISSION