"OTHER" CORNER MAP

ALLEGAN T.2N.–R.13W.

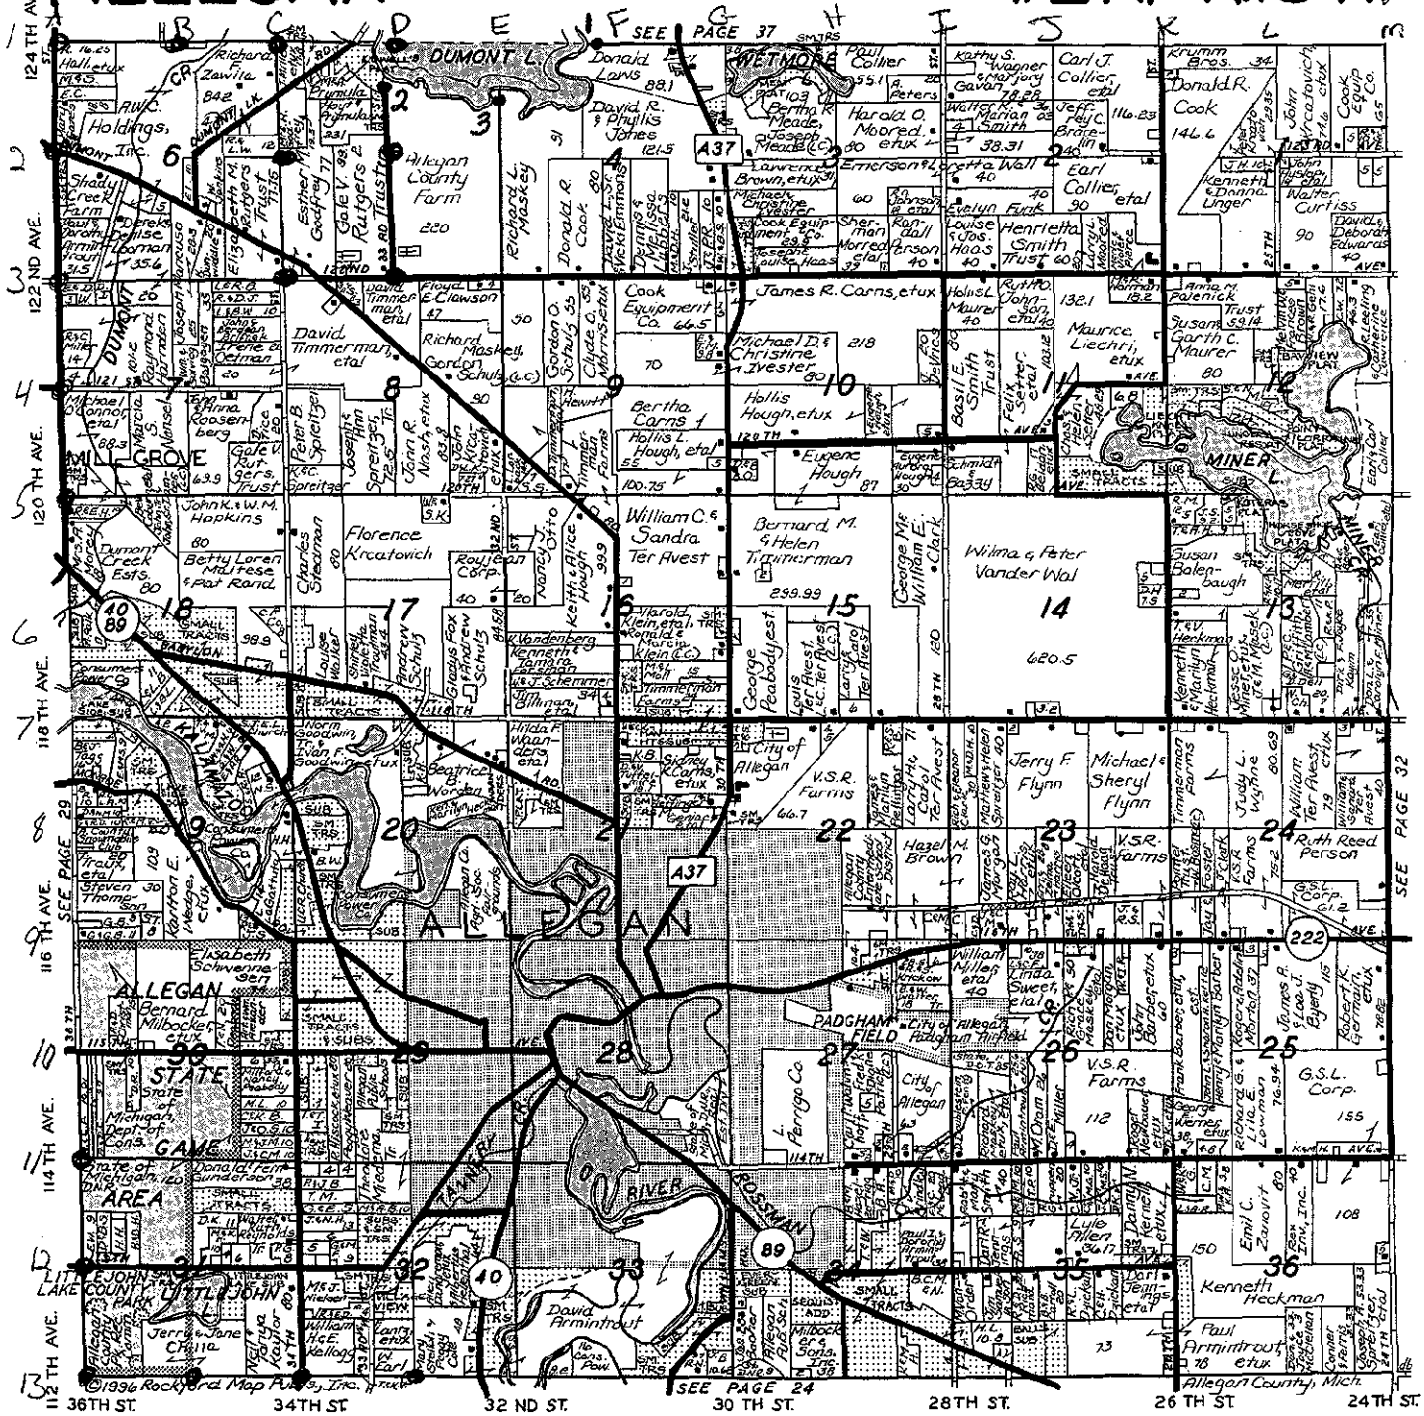

1997 = #1 1998 = #2, #3

ALLEGAN True Value HARDWARE HARDWARE STORES
& SUPPLY CO.
1527 M-40 North - Allegan, Michigan 49010
ACROSS FROM SENIOR HIGH SCHOOL
LAWN & GARDEN SUPPLIES - HARDWARE
HOUSEWARES - PAINT - TORO - SIMPLICITY
Phone: 673-3255

WRAY'S
673-4791
• SEPTIC TANKS • DRYWELLS
• SITE PREPS
1148 Lincoln Road
Allegan, Michigan 49010

Rex Hays
CHEVROLET
OLDSMOBILE
BUICK
GMC
SALES — SERVICE
PARTS
CHEVROLET
CARS - TRUCKS
LEASING
COMPLETE BODY SHOP
673-2111
Toll Free
(888) REX HAYS
M-89 EAST - ALLEGAN