
ALLEGAN COUNTY REMONUMENTATION LAND CORNER RECORDATION CERTIFICATE Filing Requirement of Act 74, Mich. P.A. 1970

					1					
<u>ALLEGA</u>	N (County)	Located in:	Corner Co	ode #			ţ .	ILED		
1. Public	c Land Survey	T <u>2N R13</u> W		C-2			1/28/1999	2:44:3	9 PM	
Prope in Sec Misce	erty Controlling	T_R T_R T_R S_T_R S_T_R S_T_R S_T_R S_T_R S_T_R	W1/4	SEC. 5 GAN TWP		D. M.	REGISTER ALLEGAN C	OUNTY • I	DS MICH	
4. Lot No	o. Recor	rded Plat				Register	of Deeds S	tamp &	File Nu	umber
5. Privat	e Claims	rded Plat			, <u>A</u>	B C	DEF	G H	I J	K L
	:				. 2	_ [_				TI
					3	ľΨ				
I, <u>ARTHUR W. BRINTNALL</u> , in a field survey on <u>27 AUG</u> , 19 <u>98</u> do hereby state that under requirements of P.A. 74, Michigan P.A. of 1970, the corner points mentioned in lines 1 and 2 above were in conformance with regulations and rules therefore as required in the current manual of survey instructions of the United States Department of the Interior, Bureau of Land Management or by a decree of a Court of Law and/or that the corner points mentioned in lines 3, 4 and 5 above were in conformance with the rules of the Michigan Board of						7-18	9	15-	14-	13
Land Survey expressed b	ors or by a Decree	of a Court of Law; established, re-e	stablished, monume	nted, recovered, found a	is 7		 - - -		 	++
•		orners, all in the same town and	d rango may bo w	and ad	8	_19	2021	22-	23	24
	on this certificate.	orners, all in the same town and	a range, may be re	ecorded	9 -		1-1-1-	 	- 	++
					10-	—30—— 	29 <u>28</u>	2 ^{'7}	26	2 ⁵ -
					11					1-1
A. Desc	ription of origin	al monument and accessori	ies and/or subsa	equent restoration:	12	_31	32——33— 	34-	35 	- 36
	,	and and and addocorp	CS diresor Subse	quent restoration.	134-					
C-2										
G.1	L.O. NORTH BET	WEEN SECTIONS 5 & 6					1111111	F MI	Chicken	
	40.0 SET QI	R SEC POST					WALE.	0000000	\C\\	
		N 29 E 18					Sich Se V	RTHUR V	11. 30.	80° 34
	B. ASH 8 1 NOV 9, 1869	S 8 W 21					B	IAMINA LAMD		
		J.W. HICKS, C.S. 40.38 TO CENTER					* % S	URYEYO	ik 🧯	
							= 1,80	No. 28407	7	₹ 3°
B. Desc	ription of corne	er evidence found and/or r	nethod applied	in restoring or re	establishin	g corner	CRASS	200000	000 M	, rive
C-2	FND 1/3" PIPE	3'± HIGH @ FE COR					Ash Til	LAND	201,111	,
J Z	FE TO N&W							,,,,,,		
										
•	EAST 2652	.82 TO CENTER SEC. 5 (E .87 TO NW COR SEC. 5 (C)-2)							
	SOUTH 2644.	76 TO SW COR SEC. 5 (C	-3)							
	PLACED ALL	EGAN CO. REMON CAP	ON 1/2" PIPE A	ND IS ACCEPTED	AS A CAF	REFUL A	ND FAITI	IFUL		
	PERPETUATI	ION OF THE POSITION O	F THE ORIGIN	IAL CORNER.						
	APPROVEDE	BY ALLEGAN PEER GRO	UP 11 AUG. 98							
C. Desci	ription of monu	ment for corner and acces	ssories establi:	shed to perpetuate	e locating t	he posit	ion of the d	corner:		
C-2		ALLEGAN CO. REMON C			_					
		ON BACK OF CERTIFICA			APP	ROVED R	EMONUMEN	TATION	CORNE	ir.
			358° 29'43" 88° 46' 29"	2974.87'			P.A. 345 OF 1 LLEGAN CO			
			178° 14' 02"	2652.82° 2644.76°	DAT	TE APPRO	VED AGG	s. // ,	199	<u>8</u> ,
		LAKE RD (1/2" IRON IN	MON BOX)		COT	UNTY REP	161.7	1.db	17 Ou	Les
	/ /		358 29' 43"	1596.21'	~					
Signed by	(http:	un W Bame	mille	Date	Sept	- B,	1998			
Cimen	Michia 11-	PREIN & NEWHOF		-	7		· · · · · · · · · · · · · · · · · · ·			
ourveyors	Michigan Licen	se No. #28407								

C-2 ALLEGAN TWP.

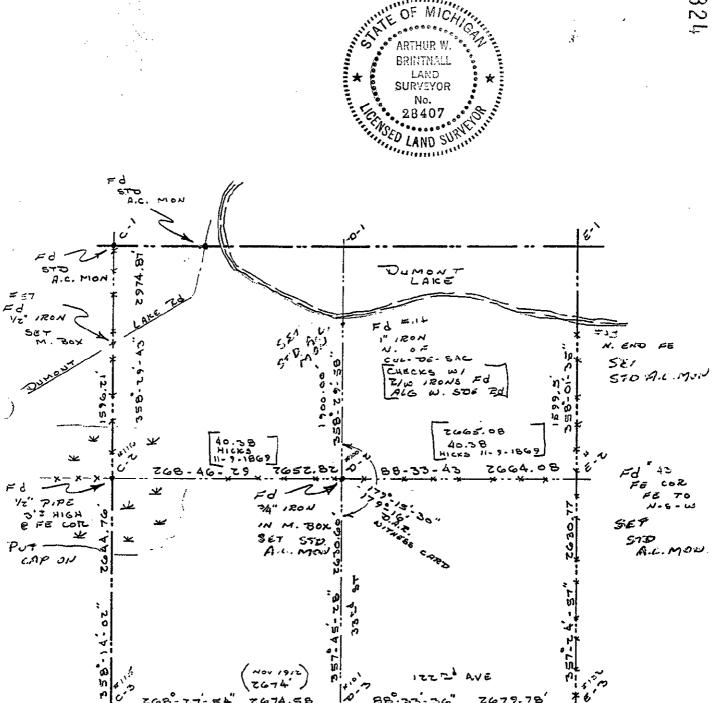

M. BOX SET

5292,54

ALL MOIS