

MAR 1 1993
 COMMISSION
 For corners in ALLEGAN (County)

ALLEGAN COUNTY REMONUMENTATION
 LAND CORNER RECORDATION CERTIFICATE
 Filing Requirement of Act 74, Mich. P.A. 1970


1993 DEC 30 PM 2:42
 REGISTER OF DEEDS
 ALLEGAN COUNTY, MICH.
 FILED
 Register of Deeds Stamp & File Number

Located In: Corner Code #/4

1. Public Land Survey	T <u>2N</u> R <u>13W</u>	C-3 (SE, 6)
	T _____ R _____	ALLEGAN TWP.
	T _____ R _____	_____
	T _____ R _____	_____
2. Property Controlling in Section	S _____ T _____ R _____	_____
	S _____ T _____ R _____	_____
3. Miscellaneous Property in Sec.	S _____ T _____ R _____	_____
	S _____ T _____ R _____	_____

4. Lot No. _____, Recorded Plat _____

5. Private Claims _____

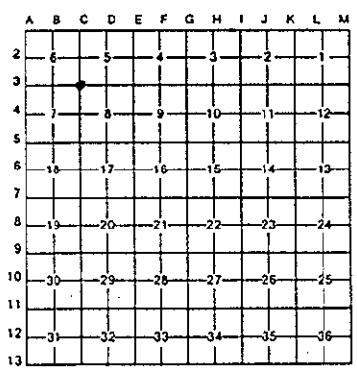

I, BASIL ADDRESS, in a field survey on DECEMBER 22, 19 93, do hereby certify that under requirements of P.A. 74, Michigan P.A. of 1970, the corner points mentioned in lines 1 and 2 above were in conformance with regulations and rules therefore as required in the current manual of survey instructions of the United States Department of the Interior, Bureau of Land Management or by a decree of a Court of Law and/or that the corner points mentioned in lines 3, 4 and 5 above were in conformance with the rules of the Michigan Board of Land Surveyors or by a Decree of a Court of Law; established, re-established, monumented, re-monumented, recovered, found as expressed below:

NOTE: Not more than 4 corners, all in the same town and range, may be recorded on this certificate.

A. Description of original monument and accessories and/or subsequent restoration:
 G.L.O. - NORTH BETWEEN SECTIONS 7 & 8, 80.00 CHS. SET POST COR. SECTIONS 5, 6, 7 & 8.
 WITNESSES: SUGAR 10 W 16 LKS. (10.56')
 BEECH 28 N 72 E 45 LKS. (29.70')


4-24-1976 - J. W. HICKS, C.S. MEAS. NORTH 20.00 CHS. (1320') TO 1/8 POST.
 COUNTY SURVEYOR'S OLD NOTES: STONE - WITNESS: CHERRY 12" WEST 2'
 1980 +/- D. A. RATEKIN, C.S. FD POINTED STONE - WITNESSES: PK NE ROOT 30" CHERRY W 0.85'
 PK NE SDE 6" TREE N 20 W 2.41'
 PK SE SDE 10" MAPLE N 50 E 15.24'

(CONTINUED ON BACK OF CERTIFICATE)

B. Description of corner evidence found and/or method applied in restoring or reestablishing corner:
 FD. POINTED STONE.
 REPLACED STONE WITH STD. ALLEGAN CO. MON.
 THIS CORNER IS ACCEPTED AS A CAREFUL AND FAITHFUL PERPETUATION OF THE POSITION OF THE ORIGINAL CORNER.

APPROVED BY THE ALLEGAN COUNTY REMONUMENTATION PEER GROUP 12-21-93.

C. Description of monument for corner and accessories established to perpetuate locating the position of the corner:
 REPLACED STONE WITH STD. ALLEGAN COUNTY MONUMENT (3/4" STEEL PIN W/ REMON. CAP)
 NAIL & REMON. WASHER EAST SDE 9" MAPLE NW 2.31'
 NAIL & REMON. WASHER NW SDE 15" MAPLE NE 15.18'
 NAIL & REMON. WASHER NORTH SDE 16" ASH SW 29.20'
 NAIL & REMON. WASHER WEST SDE 10" ELM NNE 16.56'
 NAIL & REMON. WASHER WEST SDE 11" HICKORY NORTH 40.47'

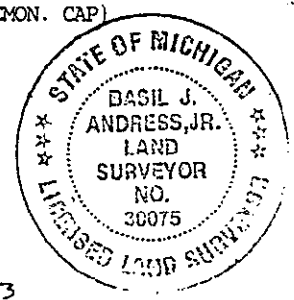

Signed by Basil J. Address Date 12-29-93
 Surveyor's Michigan License No. 30075

FORM APPROVED BY MICHIGAN STATE BOARD OF LAND SURVEYORS, JAN. 28, 1971
 REVISED MAY 14, 1975
 REVISED JAN., 1983

(CONTINUED FROM FRONT OF CERTIFICATE)

A. DESCRIPTION OF ORIGINAL MONUMENT AND ACCESSORIES AND/ OR SUBSEQUENT RESTORATION.

1988 - R. E. MOORED, L.L.S. (WIGHTMAN MOORED)

FD. STONE

WITNESSES: PK NE ROOT 30" CHERRY W 0.85'
PK NE SDE 6" TREE N 20 W 2.41'
PK SE SDE 10" MAPLE N 50 E 15.24'
NOT IN TRAVELED ROADWAY