

**ALLEGAN CO. REMONUMENTATION  
LAND CORNER RECORDATION CERTIFICATE  
Filing Requirement of Act 74, Mich. P.A. 1970**

For corners in Allegan County

FILED

LIBERO 006 PAGE 335

<u>ALLEGAN</u> (County)	Located in:	Corner Code #
1. Public Land Survey	T-2N R-13W	F-3
	T R	SI/4 SEC. 4
	T R	ALLEGAN TWP
2. Property Controlling in Section	S T R	
3. Miscellaneous Property in Sec.	S T R	

1/28/1999 2:44:39 PM  
JOYCE A. WATTS  
REGISTER OF DEEDS  
ALLEGAN COUNTY, MICH

Register of Deeds Stamp & File Number

4. Lot No. \_\_\_\_\_, Recorded Plat \_\_\_\_\_  
5. Private Claims \_\_\_\_\_

I, ARTHUR W. BRINTNALL, in a field survey on 27 AUG 19 98 do hereby state that under requirements of P.A. 74, Michigan P.A. of 1970, the corner points mentioned in lines 1 and 2 above were in conformance with regulations and rules therefore as required in the current manual of survey instructions of the United States Department of the Interior, Bureau of Land Management or by a decree of a Court of Law and/or that the corner points mentioned in lines 3, 4 and 5 above were in conformance with the rules of the Michigan Board of Land Surveyors or by a Decree of a Court of Law; established, re-established, monumented, recovered, found as expressed below:

1	A	B	C	D	E	F	G	H	I	J	K	L	M
2		6		5		4		3		2		1	
3						⊙							
4		7		8		9		10		11		12	
5													
6		18		17		16		15		14		13	
7													
8		19		20		21		22		23		24	
9													
10		30		29		28		27		26		25	
11													
12		31		32		33		34		35		36	
13													

NOTE: Not more than 2 corners, all in the same town and range, may be recorded on this certificate.

**A. Description of original monument and accessories and/or subsequent restoration:**

G.L.O.  
EAST RANDOM BETN SECS 4 & 9  
80.21 TO E BDY OF SECS 40 LKS N OF POST  
  
WEST CORRECT BETN SECS 4 & 9  
40.10 SET - QR SEC POST  
- W. ASH 10 N 22 W 10  
- W. ASH 4 S 57 E 8

APRIL 27, 1972  
- L.C.R.C. D.A. RATEKIN, C.S.  
3/4" IRON IN M. BOX  
P.K. W. SIDE PP S 15 E 65.25  
1"X2" IRON SOUTH 33.19  
CENTERLINE W. END C.M.P. N 60° E 69.7'  
42" MAPLE N 60° E 102.9'

JUNE 23, 1977  
- ACT 132 SURVEY D.A. RATEKIN, C.S.  
WITNESSES FOR F-3 SAME AS ABOVE

**B. Description of corner evidence found and/or method applied in restoring or reestablishing corner:**

FD 3/4" PIPE IN M. BOX  
PK W. SDE PP S 15° E 65.25'  
CENTERLINE W END 12" CMP N 60° E 69.7'  
E-3 (STD. A.C. MON) 269°08'47" 2642.92  
G-3 (STD A.C. MON) 89°29'39" 2626.91  
IN LINE WITH OCC. TO SOUTH  
NO OCC TO NORTH


REPLACED 3/4" PIPE WITH STD A.C. MON  
(3/4"X24" IRON WITH CAP) AND IS ACCEPTED  
AS A CAREFUL AND FAITHFUL PERPETUATION  
OF THE POSITION OF THE ORIGINAL CORNER

APPROVED REMONUMENTATION CORNER  
P.A. 345 OF 1990  
ALLEGAN COUNTY  
DATE APPROVED AUG 11 1998  
COUNTY REP. [Signature]

APPROVED BY ALLEGAN PEER GROUP 11 AUG 98

**C. Description of monument for corner and accessories established to perpetuate locating the position of the corner:**

STD A.C. MON (3/4" X 24" IRON) IN MON BOX  
SW COR HSE #3109 FND N 05°E 142.40'  
NAIL & REMON TAG TOP OF GUARD RAIL POST S 60°W 51.45'  
NAIL & REMON TAG TOP OF GUARD RAIL POST S 05° E 18.20'  
NAIL & REMON TAG S SIDE PP S 70° E 121.21'  
CENTERLINE 122<sup>ND</sup> AVE SOUTH 0.5'  
IN LINE WITH OCC. TO SOUTH

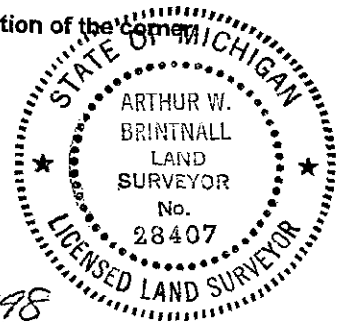

Signed by Arthur W. Brintnall  
PREIN&NEWHOF  
Surveyor's Michigan License No. #28407

Date Sept 8, 1998