

MAR 07 2000

FILED

ALLEGAN COUNTY REMONUMENTATION
LAND CORNER RECORDATION CERTIFICATE
FILING REQUIREMENT OF ACT 74, MICH. P. A. 1970

CO FEB -1 /11 8:35

SECTION

FOR CORNERS IN: ALLEGAN COUNTY	LOCATED IN:	CORNER CODE #
1. Public Land Survey	T. 2N R. 13W	G-2
WEST 1/4 COR. SEC. 3, EAST 1/4 COR. SEC. 4, T.2N., R.13W. ALLEGAN TOWNSHIP	T. R.
	T. R.
	T. R.
2. Property Controlling in section	S. T. R.
	S. T. R.
3. Miscellaneous Property in Sec.	S. T. R.
4. Lot No., Recorded Plat.		
5. Private Claims.		

Joyce A. ...
REGISTER OF DEEDS
ALLEGAN COUNTY MICH.

REGISTER OF DEEDS STAMP & FILE NUMBER

	A	B	C	D	E	F	G	H	I	J	K	L	M
2	6		5		4		3		2		1		
3													
4	7		8		9		10		11		12		
5													
6	16		17		16		15		14		13		
7													
8	19		20		21		22		23		24		
9													
10	30		29		28		27		26		25		
11													
12	31		32		33		34		35		36		
13													

I, Raymond Moored in a field survey on Sept. 23, 1999 do hereby state that under requirements of P.A 74, Michigan P.A. of 1970, corner points mentioned in lines 1 and 2 above were in conformance with regulations and rules therefore as required in the current manual of survey instructions of the United States Department of the Interior Bureau of Land management or by a decree of a Court of Law and/or that the corner points mentioned in the lines 3, 4, and 5 above were in conformance with the rules of the Michigan Board of Land Surveyors or by a Decree of a Court of Law established, monumented, recovered, found as expressed below.

Note: Not more than 2 corners, all the same town and range, may be recorded on this certificate.

A. Description of original monument and accessories and/or subsequent restoration:

SEE BACK OF SHEET FOR CORNER HISTORY

B. Description of corner evidence found and/or method applied in restoring or reestablishing corner:

FOUND 1" PIPE ON OCCUPATION LINE TO EAST. MEASURED SOUTH 2640.65' TO G-3. SPLIT OF DISTANCE TO G-3 MATCHES EAST AND WEST 1/8 LINE TO THE SOUTH. REMOVED FOUND IRON AND SET STANDARD ALLEGAN COUNTY REMONUMENTATION IRON WITH CAP.

ACCEPTED POSITION AS A CAREFUL AND FAITHFUL PERPETUATION OF THE POSITION OF THE ORIGINAL CORNER.

APPROVED BY ALLEGAN COUNTY REMONUMENTATION PEER GROUP ON DEC. 14, 1999


APPROVED REMONUMENTATION CORNER
P.A. 345 OF 1990
ALLEGAN COUNTY
DATE APPROVED DEC. 14, 1999
COUNTY REP. *[Signature]*

C. Description of monument for corner and accessories established to perpetuate locating the position of the corner:

STANDARD 3/4" X 24" ALLEGAN COUNTY REMONUMENTATION IRON WITH CAP

- NAIL IN SE'LY SIDE POWER POLE S45W 31.12'
- NAIL IN NE SIDE 16" ELM S30E 31.21'
- NAIL IN NW SIDE 12" ELM N80E 9.71'
- C/L A-37 (30TH STREET) WEST 49.30'
- 1/2" IRON W/CAP (RW) WEST 16.44'

Raymond Moored Date 12/24/99
Surveyors License No. PS# 26463

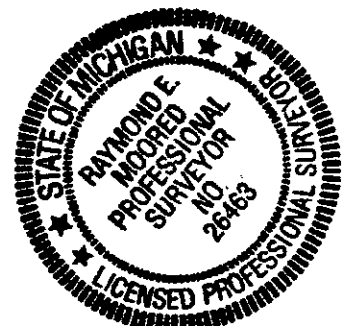

MAR 07 2000

SECTION

ALLEGAN COUNTY
ALLEGAN TOWNSHIP
T.2N., R.13W.

G-2

LENO 007 PAGE 146

A. Description of original monument and accessories and/or subsequent restoration:

1. G.L.O.
NORTH BETN SEC'S 3 & 4
40.00 SET QR SEC POST
SUGAR 15 N75W 28
SUGAR 16 N79E 20
2. COUNTY SURVEYOR FIELD NOTES (BLACK BOOK)
WITNESSES TO 1/4 POST W. SIDE SEC 3 ALLEGAN
SUGAR 15 N75W 28
SUGAR 16 N79E 20
3. COUNTY SURVEYOR FIELD NOTES (BLACK BOOK), SEPT. 5TH 1870
FROM C 1/4 TO W 1/4 IS 40.18
4. SECTION BREAK DOWN NOTES
G-1 TO G-3 = 358°05'34" 5815.46'
5. RAYMOND E. MOORED, 9-28-98, ACT 132 SURVEY
FOUND 1" PIPE
-PROP. COR. WEST 16.44'
-NAIL IN W. SIDE 18" ELM SOUTH 8.65'
-NAIL IN W. SIDE 12" ELM N20E 16.52'
-CENTERLINE ROAD WEST 49.30'

