

SURVEY &  
REMONUMENTATION

FILED

MAR 07 2000

Allegan County Remonumentation  
LAND CORNER RECORDATION CERTIFICATE  
Filing Requirement of Act 74, Mich. P.A. 1970

00 FEB -1 AM 8:35

SECTION

For corners in  
Allegan

(County)	Located in:		Corner Code #
	2N	13W	M-9 (NE 25) Allegan Twp
1. Public Land Survey	T	R	_____
	T	R	_____
	T	R	_____
	T	R	_____
2. Property Controlling in Section	S	T	_____
	S	T	_____
3. Miscellaneous Property in Sec.	S	T	_____
	S	T	_____

*Joyce A. ...*

REGISTER OF DEEDS  
ALLEGAN COUNTY

ENCLOSURE PAGE 150

Register of Deeds Stamp & File Number

4. Lot No. \_\_\_\_\_, Recorded Plat \_\_\_\_\_  
5. Private Claims \_\_\_\_\_

I, Steven Koerber, in a field survey on August 4, 1999 do hereby state that under requirements of P.A. 74, Michigan P.A. of 1970, the corner points mentioned in lines 1 and 2 above were in conformance with regulations and rules therefore as required in the current manual of survey instructions of the United States Department of the Interior, Bureau of Land Management or by a decree of a Court of Law and /or that the corner points mentioned in lines 3, 4 and 5 above were in conformance with the rules of the Michigan Board of Land Surveyors or by a Decree of a Court of Law, established, re-established, monumented, recovered, found as expressed below:

	A	B	C	D	E	F	G	H	I	J	K	L	M
1													
2	6			5			4		3			2	1
3													
4	7			8			9		10			11	12
5													
6	18			17			16		15			14	13
7													
8	19			20			21		22			23	24
9													
10	30			29			28		27			26	25
11													
12	31			32			33		34			35	36
13													

NOTE: Not more than 2 corners, all in the same town and range, may be recorded on this certificate.

A. Description of original monument and accessories and/or subsequent restoration:

M-9	GLO 1831 L.Lyons DS	1. E.P. Waterman 1890	2. Old notes from notecard file
	Set corner	Stone with 'X' on top	Iron bolt on stone
	Tamarack 16 S5W 40	No wits	20" Elm NW 108.7'
	Do. 15 N58W 15	Dist to M-10 40.19 ch.	24" Elm NW 73.9'
			Cherry NE 64.6'
			NW corner Sec. 30 Watson North 52.80'
			& noted 2.96' East of Range line

(Additional info. on back of sheet)

B. Description of corner evidence found and/or method applied in restoring or reestablishing corner:


M-9 Found 1 1/2" Iron pipe in mon. box  
MDSH tag in P.Pole S35°E 66.75'  
C/L highway North 29'±  
Set Standard Allegan Co. Mon. ( 3/4" x 24" Iron Rod with Remon.cap) at the position as occupied by the 1 1/2" iron pipe in Mon. Box.

This corner is accepted as a careful and faithful perpetuation of the position of the original corner.  
Peer Group approval August 10, 1999.  
Dist to M-8 = 2654.86'  
Dist to M-10 = 2651.20'

C. Description of monument for corner and accessories established to perpetuate locating the position of the corner:

M-9 Set Standard Allegan Co. Mon. ( 3/4" x 24" Iron Rod with Remon.cap)  
Set nail & Allegan Co. Remon. tag in W. side P.Pole N20°E 127.13'  
Set nail & Allegan Co. Remon. tag in NW side P.Pole S41°E 66.85'  
Set nail & Allegan Co. Remon. tag in W. side 12" twin Ash S30°W 162.84'  
Top corner "L" of steel "L" shaped fence post N8°W 211.06'  
NW corner Section 30, Watson Twp. (A-9) North 52.80'  
C/L highway M-222 North 29'±

APPROVED REMONUMENTATION CORNER  
P.A. 345 OF 1990  
ALLEGAN COUNTY  
DATE APPROVED Aug. 19, 1999  
COUNTY REP. [Signature]

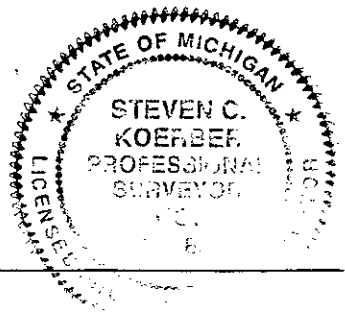

Signed by [Signature]  
Surveyor's Michigan License No. 39085

Date 12-17-1999

SURVEY &  
RECORDS SECTION

MAR 07 2000

SECTION

Page 2 of 2

M-9 ALLEGAN TWP.

3. 7-25-1973 Donald Ratekin  
Boundary survey  
Boat spike  
No wits.
4. 9-10-1973 Donald Ratekin  
Act 132 survey  
MDSH tag in P.Pole S35°E 66.75'  
SE corner of top of wingwall N10°W 94.93'  
NW corner of top of wingwall N25°E 99.80'  
C/L highway North 29.1'
5. 10-30-1973  
L.C.R.C. Liber 2, Pg. 171  
Donald Ratekin  
Found large boat spike  
Same wits as No. 4 above
6. Old notecard  
¾" bolt 2' long  
S25°W 55.70 USGS BM  
N21°W 75.15' 36" Elm  
S42°E 66.78' P.Pole
7. Holland Eng. Witness card  
Same wits as No. 4 above
8. MDOT highway plans  
NW corner Sec. 30 Watson Twp. North 52.80'
9. Kirk Van Order calcs.  
NW corner Sec. 30 Watson Twp. North 52.80'

LIBR0007 PAGE 51