

MAR 07 2000

Allegan County Remonumentation  
LAND CORNER RECORDATION CERTIFICATE  
Filing Requirement of Act 74, Mich. P.A. 1970

00 FEB -1 AM 8:36

SECTION

For corners in  
Allegan

(County)	Located In:	Corner Code #	
		2N	13W
1. Public Land Survey	T	R	M-11 (SE 25) Allegan Twp.
	T	R	
	T	R	
	T	R	
2. Property Controlling in Section	S	T	R
	S	T	R
3. Miscellaneous Property in Sec.	S	T	R
	S	T	R

*Joyce A. ...*  
REGISTER OF DEEDS  
ALLEGAN COUNTY

Register of Deeds Stamp & File Number

4. Lot No. \_\_\_\_\_, Recorded Plat \_\_\_\_\_  
5. Private Claims \_\_\_\_\_

I, Steven Koerber, in a field survey on August 4, 1999 do hereby state that under requirements of P.A. 74, Michigan P.A. of 1970, the corner points mentioned in lines 1 and 2 above were in conformance with regulations and rules therefore as required in the current manual of survey instructions of the United States Department of the Interior, Bureau of Land Management or by a decree of a Court of Law and /or that the corner points mentioned in lines 3, 4 and 5 above were in conformance with the rules of the Michigan Board of Land Surveyors or by a Decree of a Court of Law; established, re-established, monumented, recovered, found as expressed below:

NOTE: Not more than 2 corners, all in the same town and range, may be recorded on this certificate.

	A	B	C	D	E	F	G	H	I	J	K	L	M
1													
2	6		5		4		3		2		1		
3													
4	7		8		9		10		11		12		
5													
6	18		17		16		15		14		13		
7													
8	19		20		21		22		23		24		
9													
10	30		29		28		27		26		25		
11													
12	31		32		33		34		35		36		
13													

A. Description of original monument and accessories and/or subsequent restoration:

M-11 GLO 1831 L.Lyons DS 1. E.P. Waterman 1890 2. Old notes card  
Set corner Pointed stone on top 1974  
Pine 13 S67W 13 Old note dist to M-10= 40.07 ch. Set 1" iron  
Maple 6 N58W 31 Street sign N20°E 36.05'  
South leg of direction sign N85°E 18.25'  
NW corner tele. outlet S45°W 38.35'  
C/L road 6'N

(Additional info. on back of page)

B. Description of corner evidence found and/or method applied in restoring or reestablishing corner:

M-11 Found 5/8" solid rod on the edge of the gravel/pavement road surface  
Found 1 1/2" iron pipe- SW corner Section 30, Watson Twp (A-11) North 107.00'  
Set Standard Allegan Co. Mon. ( 3/4" x 24" Iron Rod with Remon.cap) at the position as occupied by the 5/8" solid iron rod.


This corner is accepted as a careful and faithful perpetuation of the position of the original corner.

Peer Group approval August 10, 1999.  
Dist to M-10 = 2651.20'  
Dist to M-12 = 2671.27'

APPROVED REMONUMENTATION CORNER  
P.A. 345 OF 1990  
ALLEGAN COUNTY  
DATE APPROVED AUG 10, 1999.  
COUNTY REP. [Signature]

C. Description of monument for corner and accessories established to perpetuate locating the position of the corner:

M-11 Set Standard Allegan Co. Mon. ( 3/4" x 24" Iron Rod with Remon.cap)  
Set nail & Allegan Co. Remon. tag in NW side P.Pole N49°E 182.31'  
Set nail & Allegan Co. Remon. tag in C/L top wood fence post N50°W 102.16'  
Set nail & Allegan Co. Remon. tag in C/L top wood fence post N79°W 61.10'  
Set nail & Allegan Co. Remon. tag in N. side P.Pole N49°E 183.08'  
SW corner Sec. 30, Watson Twp (A-11) North 107.00'

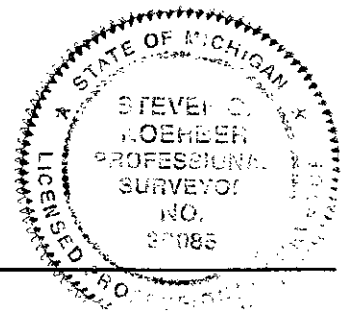

Signed by [Signature]  
Surveyor's Michigan License No. 39085

Date 12-17-1999

SURVEY &  
RECORDS SECTION

MAR 07 2000

SECTION

Page 2 of 2

M-11 ALLEGAN TWP.

3. 2-8-1974  
Donald Ratekin  
Act 132 survey  
Same wits as No. 2 above
4. 4-30-1974  
L.C.R.C. Liber 2. Page 289 Donald Ratekin  
Same wits as No. 2 above.
5. Old note distance to M-12= 2671.36'  
Distance to L-11 Allegan Twp.= 2643.70'  
Jog distance to A-11 Watson Twp. North 106.92'
6. Holland Engineering iwts.  
Same as No. 2 above

LIBRO 007 PAGE 54