

MAR 07 2000

Allegan County Remonumentation
LAND CORNER RECORDATION CERTIFICATE
Filing Requirement of Act 74, Mich. P.A. 1970

00 FEB -1 AM 8:38

SECTION

For corners in
Allegan

Located In:	Corner Code #	
	2N	13W
1. Public Land Survey	T ___ R ___	_____
	T ___ R ___	_____
	T ___ R ___	_____
	T ___ R ___	_____
2. Property Controlling in Section	S ___ T ___ R ___	_____
	S ___ T ___ R ___	_____
3. Miscellaneous Property in Sec.	S ___ T ___ R ___	_____
	S ___ T ___ R ___	_____

Joyce L. Coyle
REGISTER OF DEEDS
ALLEGAN COUNTY, MI

RECORDED / FILED

Register of Deeds Stamp & File Number

4. Lot No. _____, Recorded Plat _____
5. Private Claims _____

I, Steven Koerber, in a field survey on August 4, 1999 do hereby state that under requirements of P.A. 74, Michigan P.A. of 1970, the corner points mentioned in lines 1 and 2 above were in conformance with regulations and rules therefore as required in the current manual of survey instructions of the United States Department of the Interior, Bureau of Land Management or by a decree of a Court of Law and for that the corner points mentioned in lines 3, 4 and 5 above were in conformance with the rules of the Michigan Board of Land Surveyors or by a Decree of a Court of Law; established, re-established, monumented, recovered, found as expressed below:

NOTE: Not more than 2 corners, all in the same town and range, may be recorded on this certificate.

	A	B	C	D	E	F	G	H	I	J	K	L	M
1													
2	6		5		4		3		2		1		
3													
4	7		8		9		10		11		12		
5													
6	18		17		16		15		14		13		
7													
8	19		20		21		22		23		24		
9													
10	30		29		28		27		26		25		
11													
12	31		32		33		34		35		36		
13													

A. Description of original monument and accessories and/or subsequent restoration:

M-12	GLO 1831 L.Lyons DS	1. Old notes card	2. 1-18-1989
	Set corner	Note card dist to M-11= 2671.36	Wightman-Moored boundary survey
	W. Oak 26 is quarter	Note card dist to M-13= 2650.15	No. wits
	Section tree		right of way rerod West 33.0'
			Dist to M-13= 2650.15'
			Dist to M-11= 2671.36'

B. Description of corner evidence found and/or method applied in restoring or reestablishing corner:


M-12 Found 5/8" solid rod
Found R.M. capped rerod West 33.0'
Old fenceline to East North 53'±
Set Standard Allegan Co. Mon. (3/4" x 24" Iron Rod with Remon.cap) at the position as occupied by the 5/8" solid rod.

This corner is accepted as a careful and faithful perpetuation of the position of the original corner.
Peer Group approval August 10, 1999.
Dist to M-11 = 2671.27'
Dist to M-13 = 2650.15'

APPROVED REMONUMENTATION CORNER
P.A. 345 OF 1990
ALLEGAN COUNTY
DATE APPROVED AUG. 10, 1999
COUNTY REP. [Signature]

C. Description of monument for corner and accessories established to perpetuate locating the position of the corner:

M-12 Set Standard Allegan Co. Mon. (3/4" x 24" Iron Rod with Remon.cap)
Set nail & Allegan Co. Remon. tag in S. side 12" Hickory S85°W 34.23'
Set nail & Allegan Co. Remon. tag in SW side P.Pole S60°E 82.68'
Set nail & Allegan Co. Remon. tag in W. side P.Pole S40°W 59.62'
REM capped rerod West 33.00'
West 1/4 corner Sec. 31, Watson Twp (A-12) North 53.46'
On tree and fence line to West

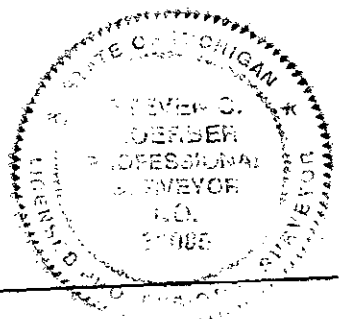

Signed by [Signature]
Surveyor's Michigan License No. 39085

Date 12-17-1999