

LAND CORNER RECORDATION CERTIFICATE
Filing Requirement of Act 74, Mich. P.A. 1970

For corners in
ALLEGAN

(County)	Located In:	Corner Code //
1. Public Land Survey	T 2N R 14W	K8
	T _____ R _____	_____
	T _____ R _____	_____
	T _____ R _____	_____
2. Property Controlling in Section	S 23 T 2N R 14W	15
	S _____ T _____ R _____	_____
3. Miscellaneous Property in Sec.	S _____ T _____ R _____	_____
	S _____ T _____ R _____	_____

Register of Deeds Stamp & File Number

4. Lot No. _____, Recorded Plat _____
 5. Private Claims _____

I, **GARY C. BILOW**, in a field survey on **April 30, 1991**, 19____ do hereby certify that under requirements of P.A. 74, Michigan P.A. of 1970, the corner points mentioned in lines 1 and 2 above were in conformance with regulations and rules therefore as required in the current manual of survey instructions of the United States Department of the Interior, Bureau of Land Management or by a decree of a Court of Law and/or that the corner points mentioned in lines 3, 4 and 5 above were in conformance with the rules of the Michigan Board of Land Surveyors or by a Decree of a Court of Law, established, re-established, monumented, re-monumented, recovered, found as expressed below:

NOTE: Not more than 4 corners, all in the same town and range, may be recorded on this certificate.

	A	B	C	D	E	F	G	H	I	J	K	L	M
2	6	5	4	3	2	1							
3													
4	7	8	9	10	11	12							
5													
6	18	17	16	15	14	13							
7													
8	19	20	21	22	23	24							
9													
10	30	29	28	27	26	25							
11													
12	31	32	33	34	35	36							
13													

A. Description of original monument and accessories and/or subsequent restoration:

(K-8) CORNER POST ESTABLISHED BY U.S. GOVERNMENT DEPUTY SURVEYOR C. BRITAIN, 1831. ACCESSORIES: PINE 10 S24W 64, DO 12 S21E 85. DEPUTY COUNTY SURVEYOR K.P. CORBYN NOTES ACCESSORIES IN RECORD DATED NOV. 1873: PINE 18 S70W 174.5, W. OAK 6 S65 1/2E 93. MONUMENT TYPE NOT NOTED. NOTES OF D.A. RATEKIN, R.L.S. 88781 SHOW: "IRON SET 4-63. 6" B. OAK SSE 18.6', 12" W. CHERRY SE 61.5', 11" W. OAK SW 36.8". CORNER ALSO SHOWN AS AN IRON ON A 1978 SURVEY BY J.H. DILLINGHAM, R.L.S. #16927 RECORDED IN LIBER 941, PAGE 776. ACCESSORIES NOTED ARE THE SAME AS ABOVE.

(15) CORNER NOT ESTABLISHED IN ORIGINAL SURVEY. FOUND NO SUBSEQUENT RECORD.


B. Description of corner evidence found and/or method applied in restoring or reestablishing corner:

(K-8) ORIGINAL POST AND ACCESSORIES NOT RECOVERED. FOUND AND ACCEPTED A 1 1/4" IRON PIPE IN SUBSTANTIAL ACCORD WITH ALL OF RATEKIN'S ACCESSORIES NOTED ABOVE. CORBYN'S PINE (NOW 32") WAS RECOVERED AT RECORD BEARING AND DISTANCE. WHITE OAK WAS NOT FOUND. REPLACED PIPE WITH A 1/2"x3/8" REBAR ENCASED IN A 4" DIAMETER CONCRETE CYLINDER CAPPED WITH A CAST ALUMINUM MICHIGAN DEPARTMENT OF NATURAL RESOURCES TABLET PROJECTING 4" ABOVE GROUND.

(15) FOUND NO MONUMENTATION AT THIS POSITION. ESTABLISHED CORNER MIDWAY AND ON A STRAIGHT LINE BETWEEN ADJACENT CORNERS I-9 AND J-9, BOTH AS RECORDED THIS DATE. AT THE POSITION FOR THE CORNER, I PLACED A 1/2"x3/8" REBAR ENCASED IN A 4" DIAMETER CONCRETE CYLINDER CAPPED WITH A CAST ALUMINUM MICHIGAN DEPARTMENT OF NATURAL RESOURCES TABLET SET 6" BELOW SURFACE IN SANDY SOIL AND SURROUNDED BY PIECES OF BROKEN BRICK.

C. Description of monument for corner and accessories and/or subsequent restoration to perpetuate locating the position of the corner:

K-8 SET CONCRETE MONUMENT WITH MDNR CAP
 S15E 19.31' FND NAIL IN WEST FACE 11" B. OAK;
 S85W 19.96' FND NAIL IN SOUTH FACE 7" WHITE PINE;
 S80E 15.84' FND NAIL IN SOUTH FACE 12" WHITE PINE;
 S40W 17.48' SET NAIL AND MDNR TAG IN SE FACE 5" WHITE PINE;
 S50E 88' CENTER OF 30" WHITE PINE;
 SOUTH 0.7' "1" POST PROJECTING 2.5'

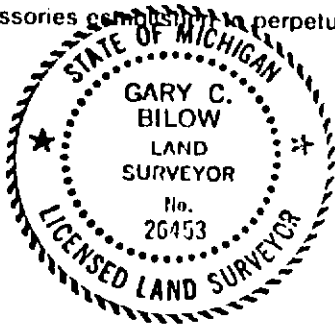

(15) SET CONCRETE MONUMENT WITH MDNR CAP
 S80W 33.73' SET NAIL AND MDNR TAG IN NORTH FACE 12" B. OAK;
 N20W 41.06' SET NAIL AND MDNR TAG IN EAST FACE 7" W. OAK;
 N50E 30.80' SET NAIL AND MDNR TAG IN EAST FACE 7" W. OAK;
 N75E 57.91' SET NAIL AND MDNR TAG IN NORTH FACE 5" W. PINE.
 BLAZED THE OAKS NOTED ABOVE AT BASE AND BH.

Signed by Gary C. Bilow Date 9-30-91
 Surveyor's Michigan License No. 26453