

LAND CORNER RECORDATION CERTIFICATE
Filing Requirement of Act 74, Mich. P.A. 1970

For corners in
ALLEGAN

(County)	Located In:	Corner Code //
1. Public Land Survey	T 2N R 14W	19
	T 2N R 14W	K9
2. Property Controlling in Section	T R	
	S T R	
3. Miscellaneous Property in Sec.	S T R	
	S T R	

Register of Deeds Stamp & File Number

4. Lot No. _____, Recorded Plat _____
 5. Private Claims _____

	A	B	C	D	E	F	G	H	I	J	K	L	M
2	6	5	4	3	2	1							
3													
4	7	8	9	10	11	12							
5													
6	18	17	16	15	14	13							
7													
8	19	20	21	22	23	24							
9													
10	30	29	28	27	26	25							
11													
12	31	32	33	34	35	36							
13													

I, **GARY C. BILOW**, in a field survey on April 30, 1991, 19____, do hereby certify that under requirements of P.A. 74, Michigan P.A. of 1970, the corner points mentioned in lines 1 and 2 above were in conformance with regulations and rules therofore as required in the current manual of survey instructions of the United States Department of the Interior, Bureau of Land Management or by a decree of a Court of Law and/or that the corner points mentioned in lines 3, 4 and 5 above were in conformance with the rules of the Michigan Board of Land Surveyors or by a Decree of a Court of Law, established, re-established, monumented, re-monumented, recovered, found as expressed below:

NOTE: Not more than 4 corners, all in the same town and range, may be recorded on this certificate.

A. Description of original monument and accessories and/or subsequent restoration:

(I-9) ORIGINAL CORNER POST ESTABLISHED BY U.S. GOVERNMENT DEPUTY SURVEYOR C. BRITAIN, 1831. ACCESSORIES: PINE 18 574W 24, DO 14 N47E 1.41. PERSONAL RECORD OF FORMER ALLEGAN COUNTY SURVEYOR HUGH MacDOUGALL (ca. 1900) SHOWS "FD STAKE" WITH ACCESSORIES AS FOLLOWS: OAK 8° NW 58', OAK 14° NE 135.6'. DISTANCES ARE SHOWN TO ADJACENT CORNERS H-9 (2655.5'), I-8 (2636'), AND I-10 (2636.75'). FOUND NO OTHER RECORD OF THIS CORNER.

(K-9) ORIGINAL CORNER POST ESTABLISHED BY U.S. GOVERNMENT DEPUTY SURVEYOR C. BRITAIN, 1831. ACCESSORIES: W. OAK 28 S49E 67, PINE 13 S88W 52. FOUND NO SUBSEQUENT RECORD.


B. Description of corner evidence found and/or method applied in restoring or reestablishing corner:

(I-9) ORIGINAL POST AND ACCESSORIES NOT RECOVERED. MacDOUGALL'S STAKE AND ACCESSORIES NOT RECOVERED. REESTABLISHED CORNER MIDWAY (PROPORTIONATE TO ORIGINAL MEASURE) AND ON A STRAIGHT LINE BETWEEN I-10 AND I-8 AS RECORDED THIS DATE. DID NOT PROPORTION EAST-WEST DUE TO A SUSPECTED ERROR IN ORIGINAL MEASURE ALONG THE SOUTH LINE OF SECTION 23. DISTANCE WEST (2653.27') FROM THIS POSITION TO AN OLD FENCE LINE AT H-9 IS VERY NEARLY IN THE SAME PROPORTION TO MacDOUGALL'S MEASURE AS DISTANCE BETWEEN I-8 AND I-10 (5264.9' MEASURED). AT THE POSITION ESTABLISHED, I PLACED A 1/2"x36" REBAR ENCASED IN A 4" DIAMETER CONCRETE CYLINDER CAPPED WITH A CAST ALUMINUM MICHIGAN DEPARTMENT OF NATURAL RESOURCES TABLET.

(K-9) ORIGINAL POST AND ACCESSORIES NOT RECOVERED. FOUND CORNER MONUMENTED WITH A 1/2" PIPE AND A 5' HIGH MOLMANIZED WOODEN POST ADJACENT. PIPE CHECKS ACCEPTABLY WITH GOVERNMENT CORNERS NORTH AND SOUTH. MEASUREMENT WEST TO J-9 IS 15.5' SHORTER THAN GLO RECORD AND WEST TO I-9 IS 47.5' SHORTER. THIS DISCREPANCY IS NOTED AS A PROBABLE ERROR IN THE ORIGINAL MEASURE. ACCEPTED 1/2" PIPE AS THE BEST AVAILABLE EVIDENCE OF THE ORIGINAL CORNER LOCATION AND REPLACED SAME WITH A 1/2"x36" REBAR ENCASED IN A 4" DIAMETER CONCRETE CYLINDER CAPPED WITH A CAST ALUMINUM MICHIGAN DEPARTMENT OF NATURAL RESOURCES TABLET.

C. Description of monument for corner and accessories established to perpetuate locating the position of the corner:

I-9 SET CONCRETE MONUMENT WITH MDNR CAP PROJECTING 6" ABOVE GROUND. N45E 12.09' SET NAIL AND MDNR TAG IN SE FACE 7° 8. OAK; S40E 40.73' SET NAIL AND MDNR TAG IN SW FACE 7° W. PINE; S85W 26.32' SET NAIL AND MDNR TAG IN SOUTH FACE 5° W. PINE; N50W 30.00' SET NAIL AND MDNR TAG IN SW FACE 13° 8. OAK; NW 0.6' 5' HIGH MOLMANIZED WOOD POST. ALL TREES NOTED WERE BLAZED AT BASE AND BH.

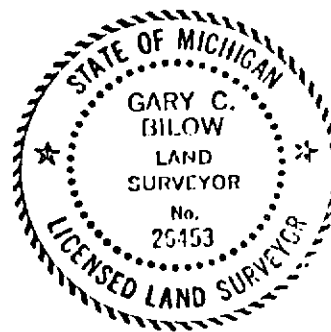

Signed by Gary C. Bielow Date 9-30-91
 Surveyor's Michigan License No. 26453