Plast. Property
Sec. 16, T2N, R14W.
Mich. exc. 6½
[illegible] thereof.
[illegible] Sec. 16,
[illegible] W. a
[illegible] of
[illegible] 33°40' W.,
[illegible] last described
to the S.W. Corner
[illegible] making
[illegible] distance of
[illegible] W. ¼ line
[illegible] 618 on bank

0-7°	[illegible] 210'
[illegible]	0°00'
[illegible]	0°58'
[illegible]	2°43'
[illegible]	[illegible]°26'
[illegible]	5°[illegible]½'

FROM ALLEGAN DAM #1
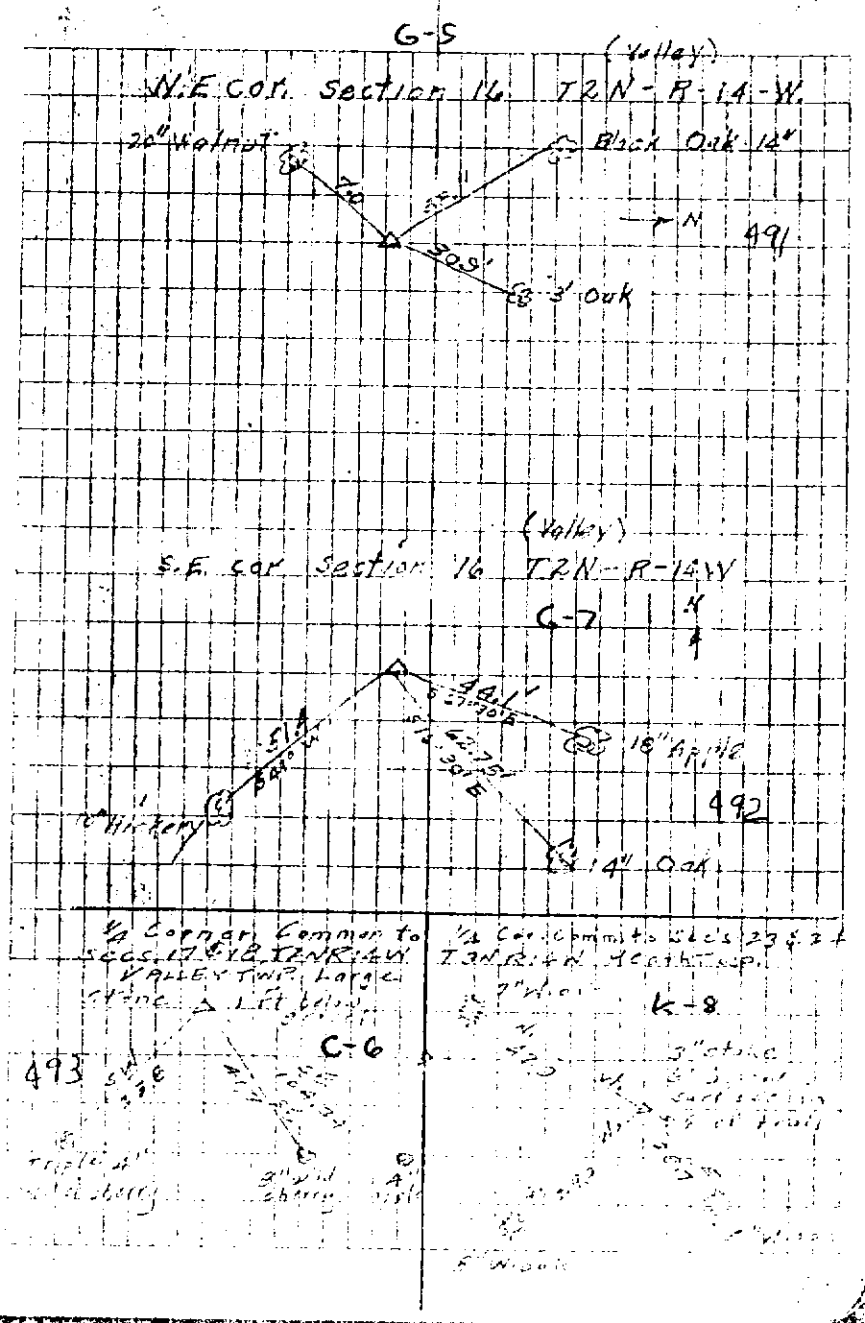
79