


FROM ALLEGAN DAM #1

1937 25

Point of ending app. N.E. cor
of Sec. -17

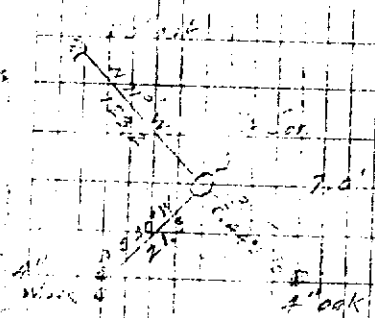

E-6

7.0' is 7.0' E.
of E. 1/4 Cor. Sec. 17
T2N R14W

Sta. 13.14' of S 1/8 cor