


160

FROM ALLEGAN DAM #7

Witnesses to NW Cor. Sec. 5
T 2 N R 14 W.

C-1 Cor. F. Post

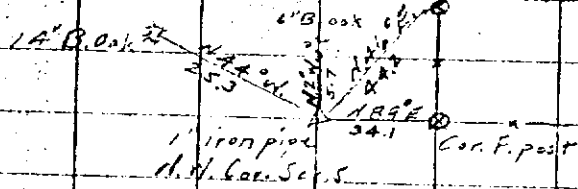

Level Check 4-23-1937

A/G	3.815	Point A	= 4.25
B/G	4.25	B	4.715
	4.65		

M₁₁-N₁₁ 456.0

N₁₁-P₁₁

P₁₁-Q₁₁ 320.6

Q₁₁-R₁₁ 719.9

J₁₁-K₁₁ 554.9 R₁₁-S₁₁ 454.6

K₁₁-L₁₁ 589.1 S₁₁-T₁₁ 433.9

L₁₁-M₁₁ 401.6 T₁₁-T₁ 339.2

D = 30°
D = 7'40"
T = 200.4
L = 391.3

26. = 0°00' ✓
+50 = 1°05' ✓
1 = 3°50' ✓
+50 = 5°45' ✓
2 = 7°25' ✓
+50 = 9°35' ✓
3 = 11°30' ✓
+50 = 13°25' ✓
PT+ 113 15°00' ✓

At 227 PC 0°00'

(273)
+50 - 1°03'
5 - 2°58'
+50 - 4°53'
6 - 6°48'
+50 - 8°43'
7 - 10°38'
+50 - 12°33'
8 - 14°28'
6+38 P.T. - 15°50'