


FROM ALLEGAN DAM # 41

41

Curve Data

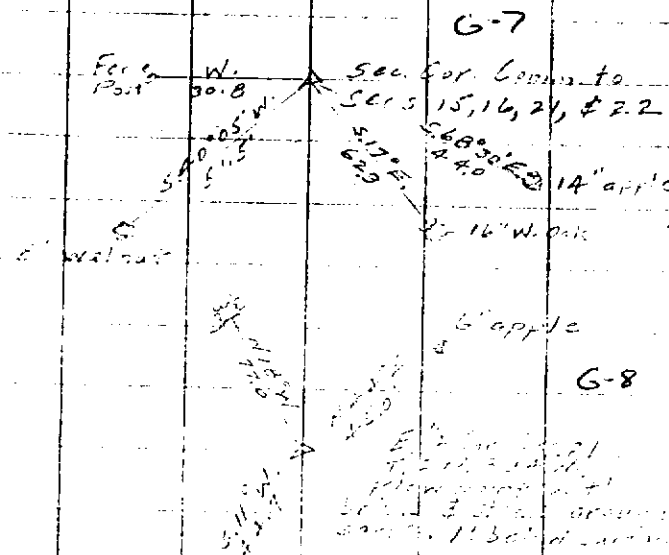

G-7

Sec. Cor. Comm. to
SECS 15, 16, 21, & 22

S 68° 30' E 4.40

14" apple
16" W. Oak

6' apple

G-8